


T. 35S. R. 2W., W.M.

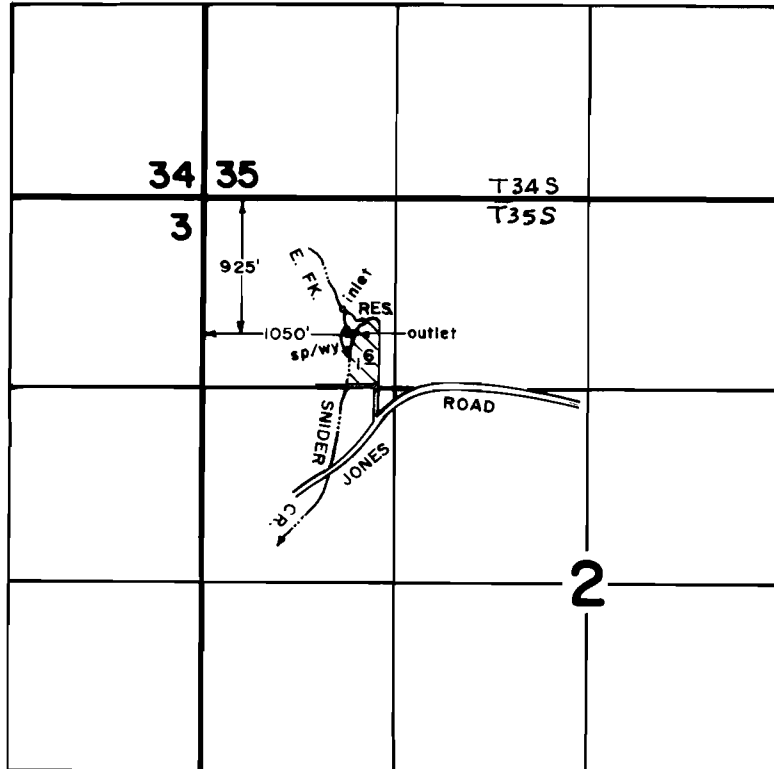

FINAL PROOF SURVEY UNDER

R-45519 R-5381

Application No. **45520** Permit No. **33969**...
IN NAME OF

..... **HERBERT S. LINGREN**

Surveyed **JULY 14**, 19**82**, by **B. SUZIE JAMES**

SCALE: 4" = 1 MILE