


T. 37 S., R. 2 W., W. M.

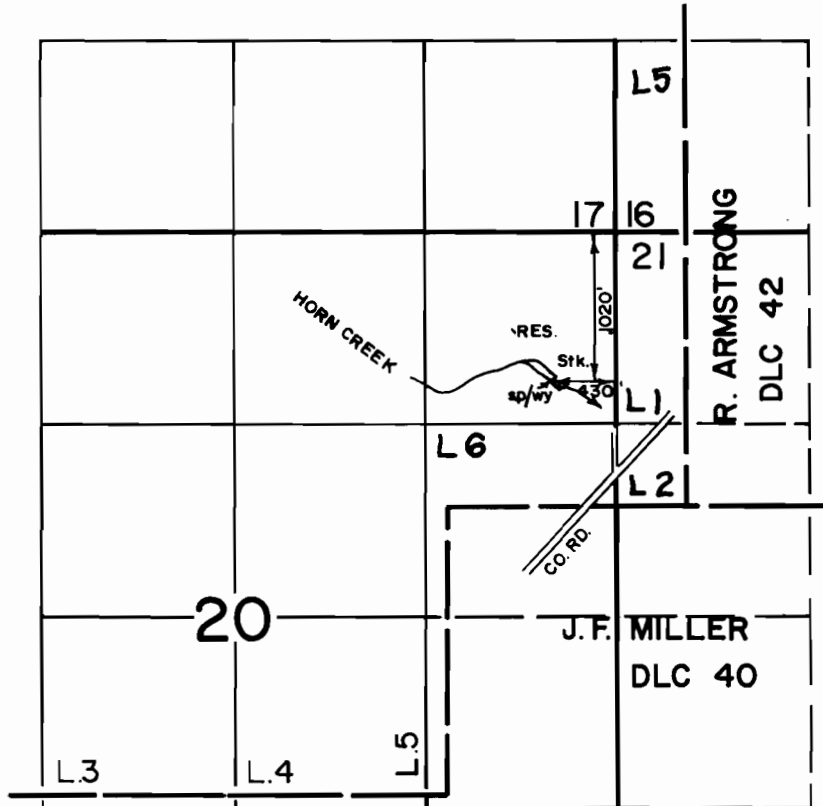

FINAL PROOF SURVEY
UNDER

Application No. R-48811 Permit No. R-5918....
IN NAME OF

.....*JEAN FORSTER*.....

Surveyed Oct. 21, 1982, by B.S. JAMES.....

SCALE 4" = 1 mile