


T. 39S., R. 2W., W.M.

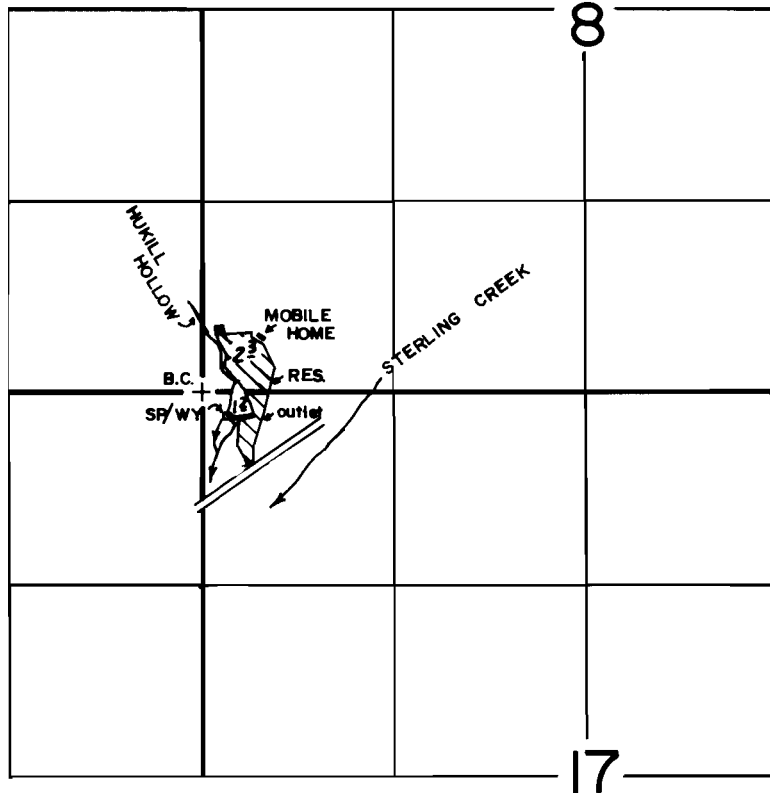

RES. LOCATED: 190' S & 230' E FROM NW COR. SEC. 17.
 DIV. PT.: 290' S & 900' E FROM NW COR. SEC. 17.

FINAL PROOF SURVEY UNDER

R-50030 R-6099
 Application No. 50031.. Permit No. 37613.....
 IN NAME OF

.....RICHARD & PATRICIA DARCY.....

Surveyed May...3... 1982, by B.R. SUND.....

SCALE 4" = 1 Mile