


T. 39S., R. 2W., W.M.

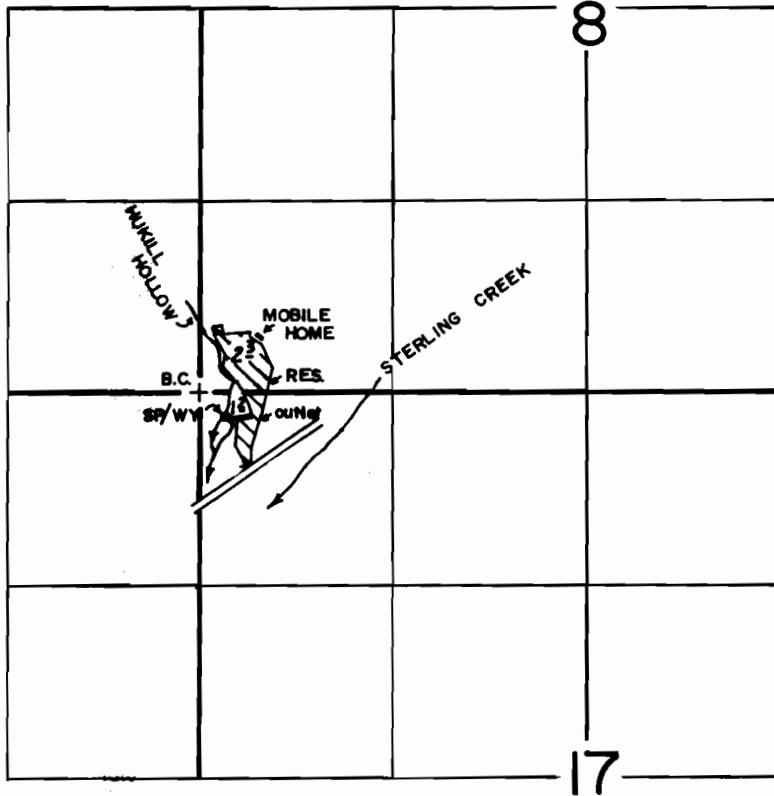

RES. LOCATED: 190'S & 230'E FROM NW COR. SEC. 17.
DIV. PT.: 290'S & 900'E FROM NW COR. SEC. 17.

SEE R 50030/SEC. 17

FINAL PROOF SURVEY
UNDER

R-50030 R-6099
Application No. 50031.. Permit No. 37613.....
IN NAME OF

...RICHARD & PATRICIA DARCY...

Surveyed May 3, 1982, by B.R. SUND.....

SCALE 4" = 1 Mile