


T. 38 S., R. 2 W., W.M.

SEC. 28

SW 1/4 NW 1/4

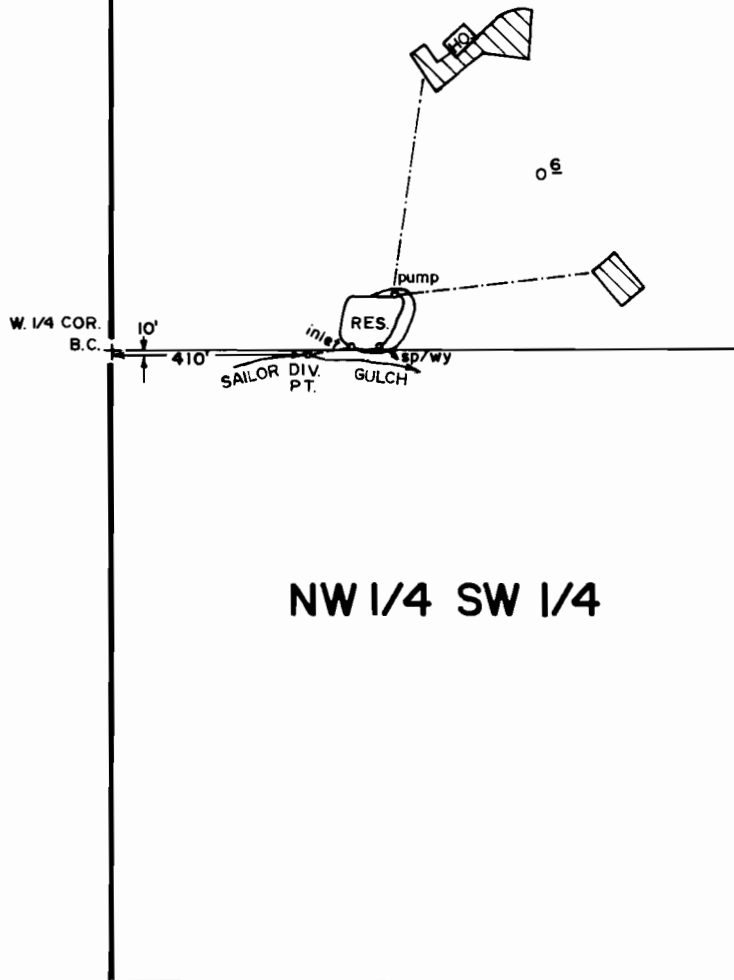

FINAL PROOF SURVEY
UNDER

Application No. R-50743 50744 Permit No. R-6194 38325

IN NAME OF

ALBERT L. & SADIE L. NELSON

Surveyed MAY 5 1982, by BRUCE R. SUND

SCALE: 1" = 400'