


T. 38 S., R. 2 W., W.M.

SEC. 28

SW 1/4 NW 1/4

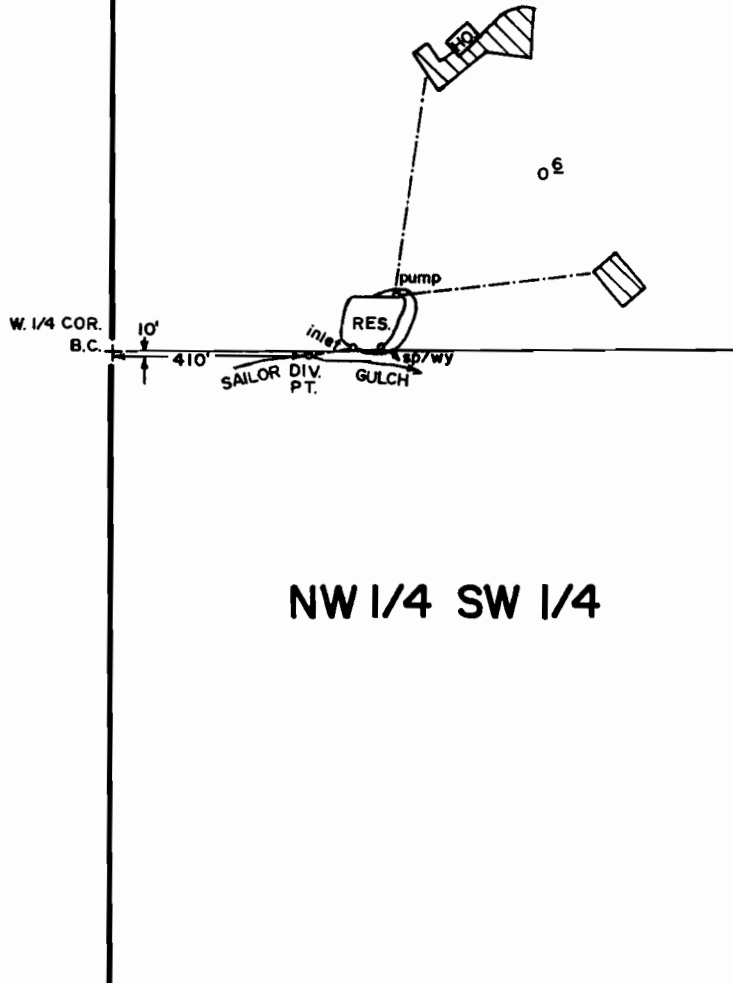

FINAL PROOF SURVEY
UNDER

Application No. **R-50743** Permit No. **R-6194**
50744 **38325**

IN NAME OF

ALBERT L. & SADIE L. NELSON

Surveyed **MAY 5** 19 **82**, by **BRUCE R. SUND**

SCALE: 1" = 400'