


T. 38 S., R. 4 W., W.M.

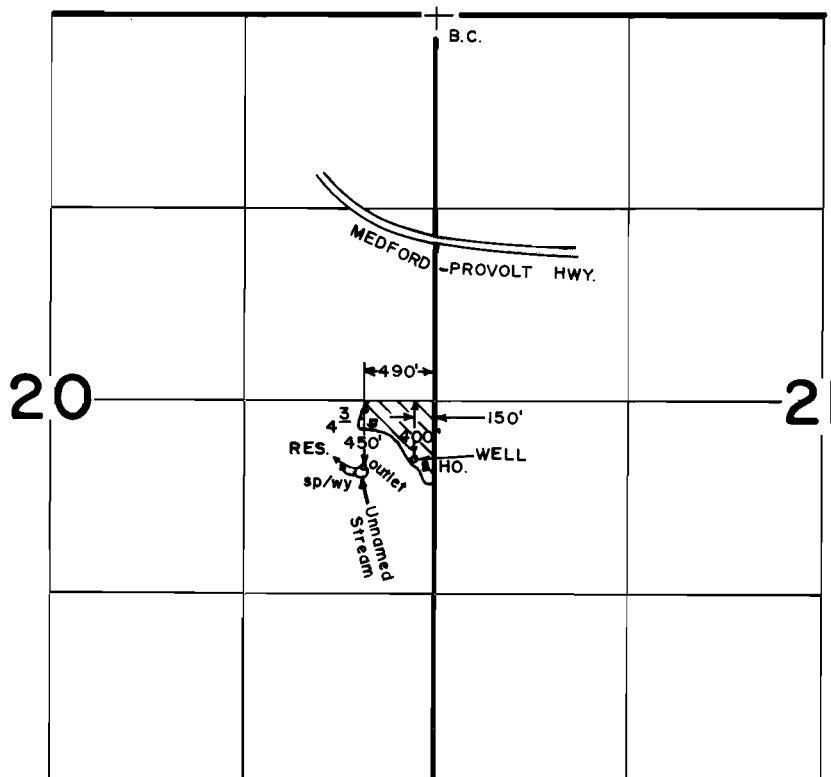

FINAL PROOF SURVEY
UNDER

R-58688 R-7963
Application No. G-9249 Permit No. G-8680
IN NAME OF

.....**RUDOLPH ACKERMAN**.....

Surveyed **JULY 16**, 19**82**, by **B. S. JAMES**.....

SCALE: 4" = 1 MILE