


T. 35 S., R. 2 E., W. M.

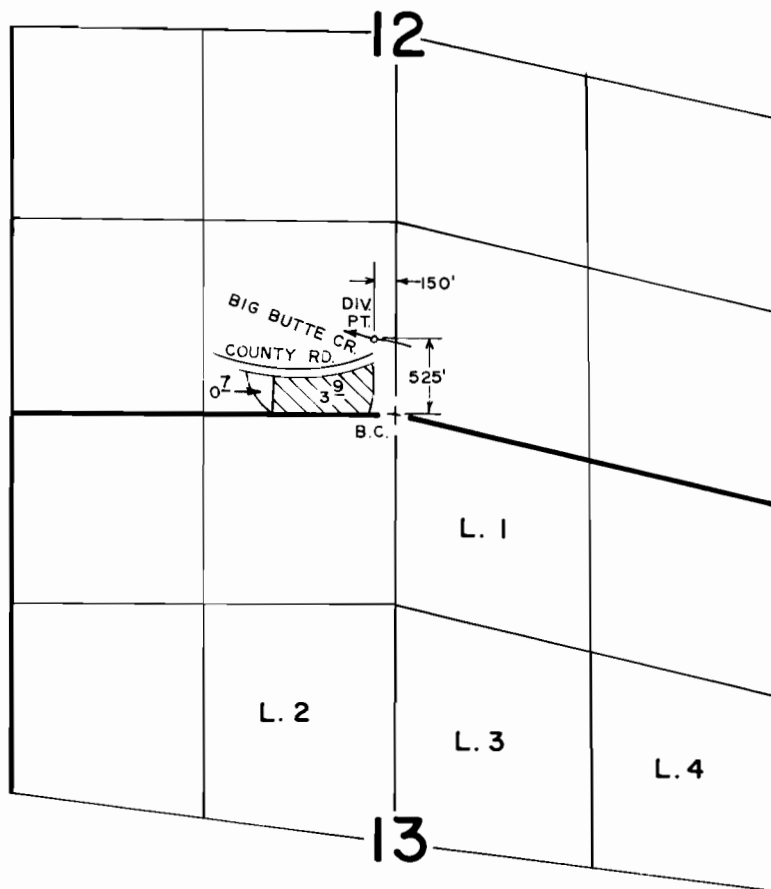

FINAL PROOF SURVEY
UNDER

TRANSFER NO. 2569 & 2568
Application No. Permit No.
IN NAME OF

..... ROBERT EARLE POWELL

Surveyed JULY 15... 1982, by BRUCE R. SUND

SCALE: 4" = 1 MILE