


T.35S. R.3W.W.M.

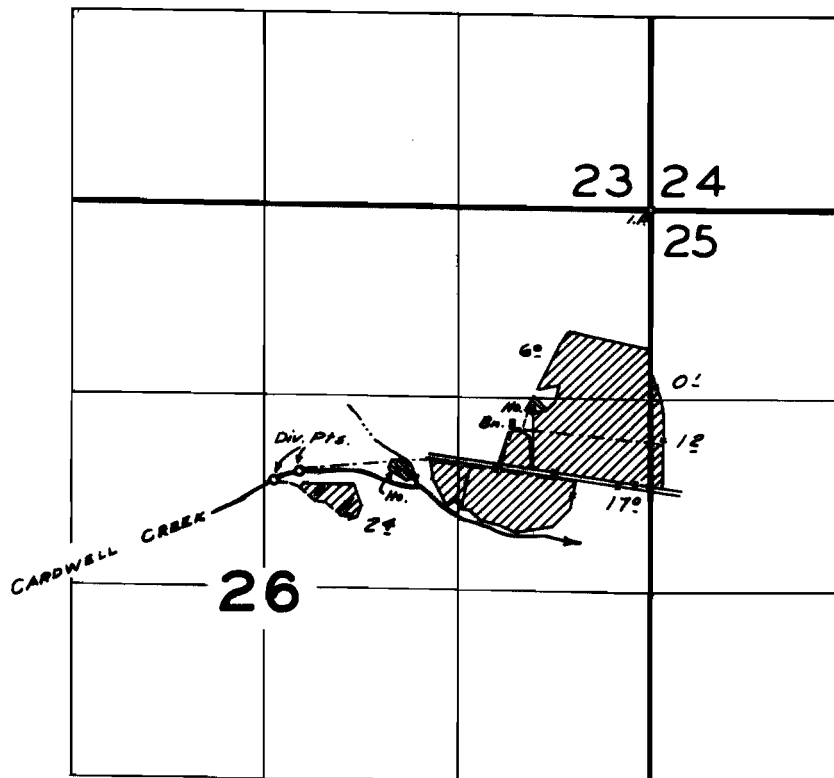


FINAL PROOF SURVEY
UNDER

Application No. ²⁷⁴⁰⁹~~29549~~ Permit No. ²¹⁵⁸⁵~~23282~~
IN NAME OF

J. W. FITZGERALD

Surveyed 6 April 1960, by R. H. Jackson

T.35S. R.3W.W.M.

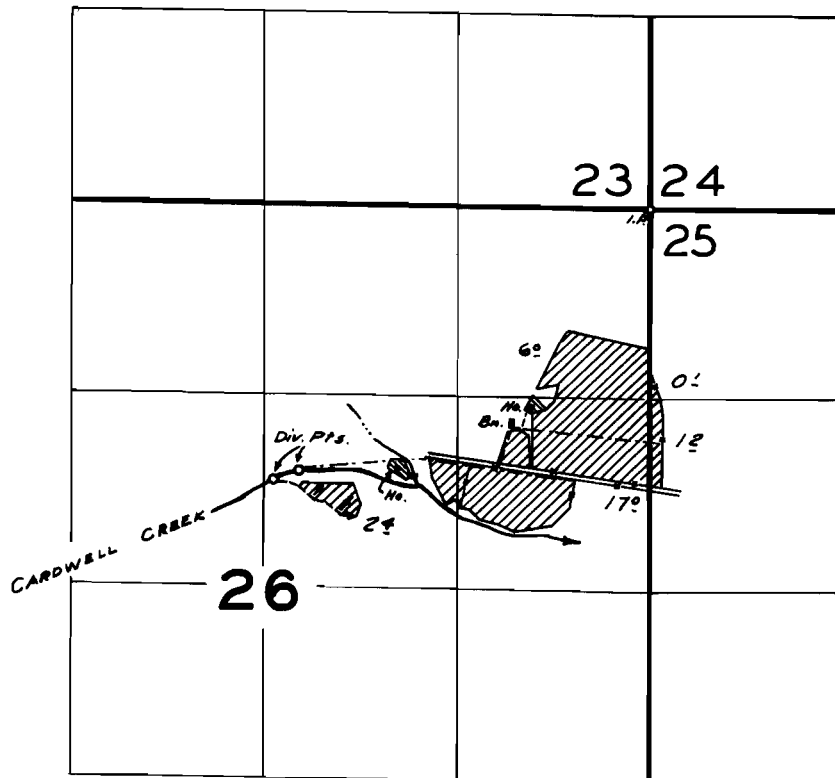

FINAL PROOF SURVEY
UNDER

Application No. ²⁷⁴⁰⁹~~29549~~ Permit No. ²¹⁵⁸⁵~~23282~~.....
IN NAME OF

J. W. FITZGERALD

Surveyed 6 April 1960, by *R. H. Jackson*