


T. 36 S., R. 4 W., W. M.

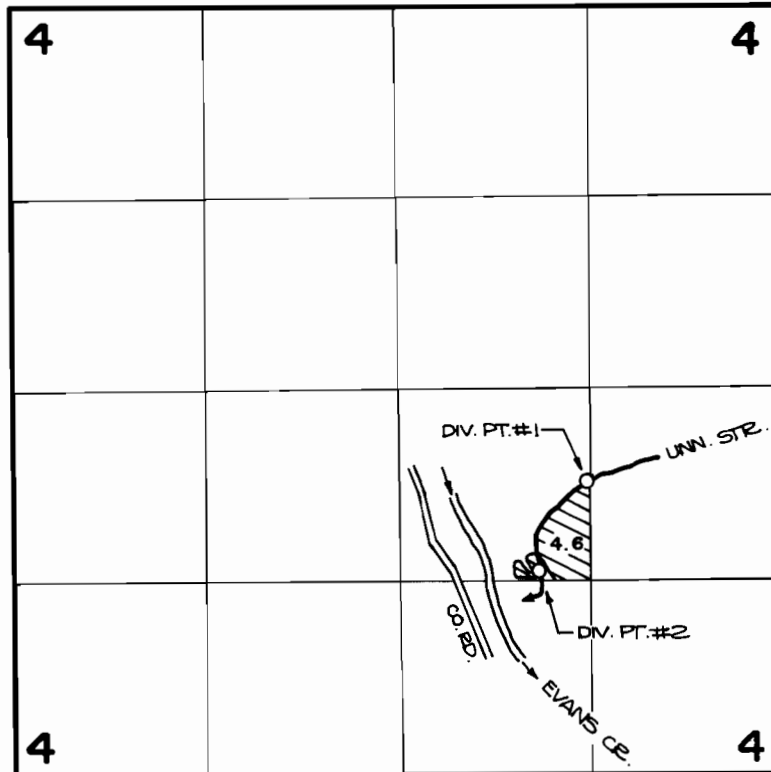

DIV. PT. #1 IS LOCATED 650'S. AND 1350'W.; DIV. PT. #2 IS LOCATED 1210'S. AND 1700'W.; BOTH FROM THE E. 1/4 CORNER OF SECTION 4.

SCALE : 4" = 1 MILE

FINAL PROOF SURVEY UNDER

Application No. ~~4.4245~~ Permit No. ~~33049~~....
IN NAME OF

.....*Morris M. Jones*.....

Surveyed Nov. 24, 1981., by Bruce....R....Sund