


T. 35S., R. 1W., W.M.

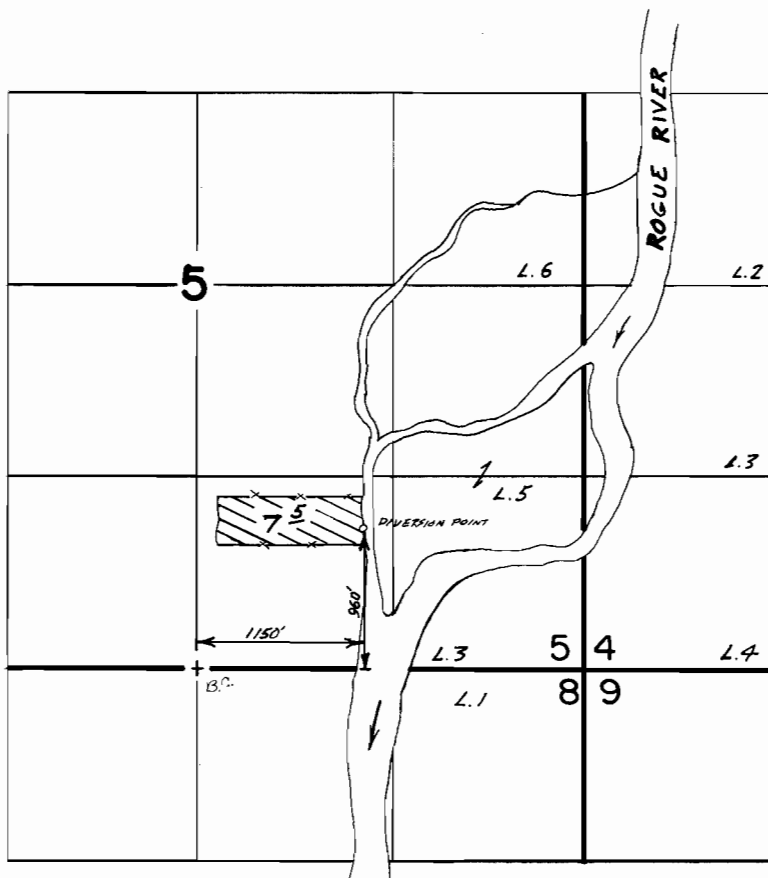

Scale 1" = 1320'

FINAL PROOF SURVEY UNDER

Application No. 48456 Permit No. 36370.....
IN NAME OF

DAVID P. ENGLESON D. D. S.....

Surveyed Nov. 6, 1985, by B.S. JAMES.....