


T. 38 S., R. 3 W., W.M.

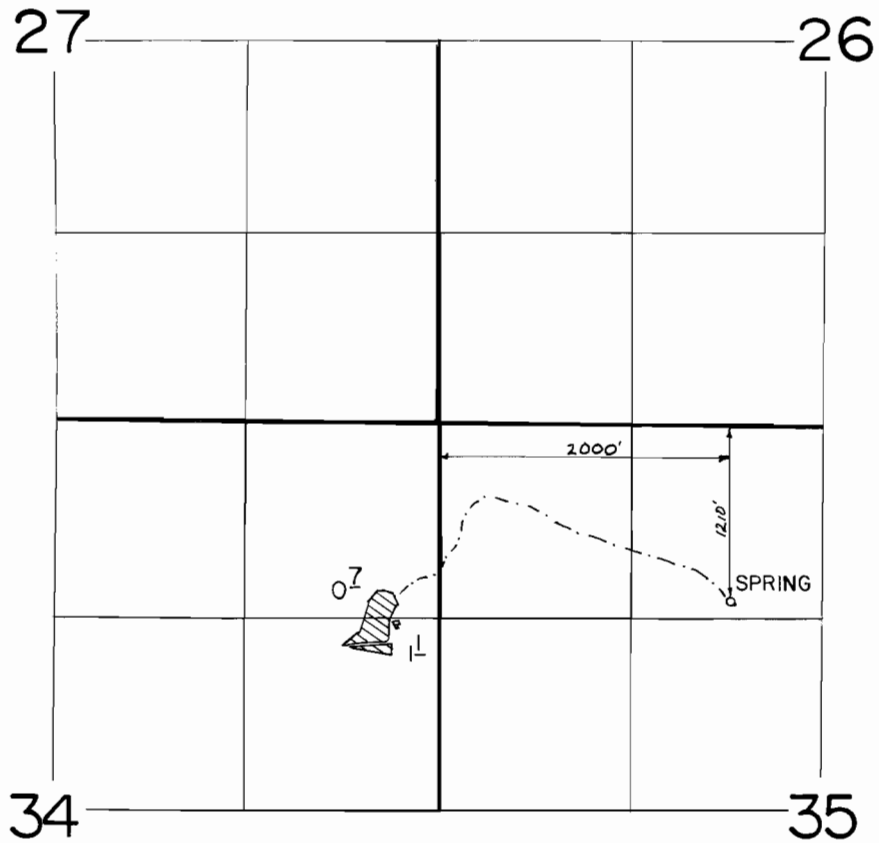

FINAL PROOF SURVEY
UNDER

Application No. 49284 Permit No. 36936.....
IN NAME OF

R. L. CHRISTEAN.....

Surveyed APRIL 20, 1982., by B.R. SUND.....