


T. 34 S., R. 1 W., W.M.
SEC. 15

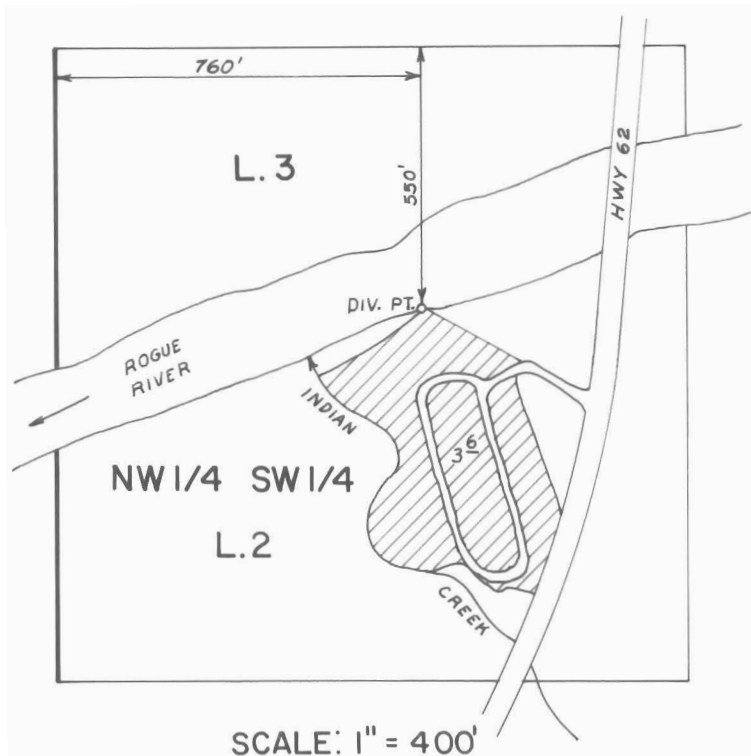

FINAL PROOF SURVEY
UNDER

Application No. 49468 Permit No. 37055
IN NAME OF

THOMAS L. DENMAN

Surveyed NOV. 4 1982, by B. S. JAMES