


T. 34 S., R. 3 W., W. M.

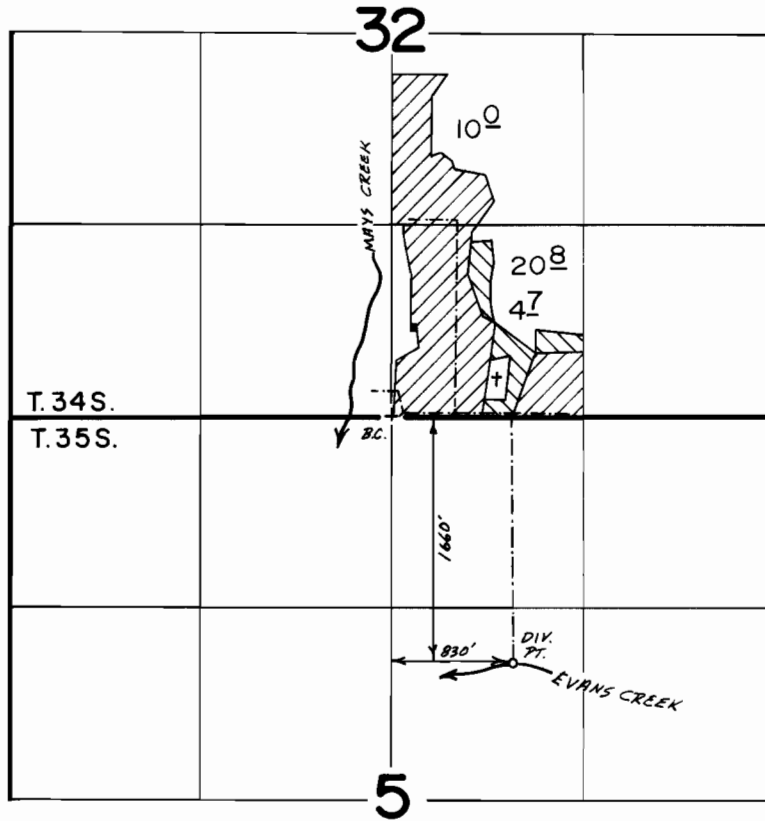

N
SCALE
1" = 1320'

▨ PRIMARY
▨ SUPPL.

FINAL PROOF SURVEY UNDER

Application No. 53268 Permit No. 39529.....
IN NAME OF

.....C. D. GREENLAW.....

Surveyed Sept. 15, 1981, by B. SUND.....