
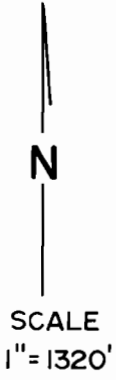


T.34S., R.3W., W.M.

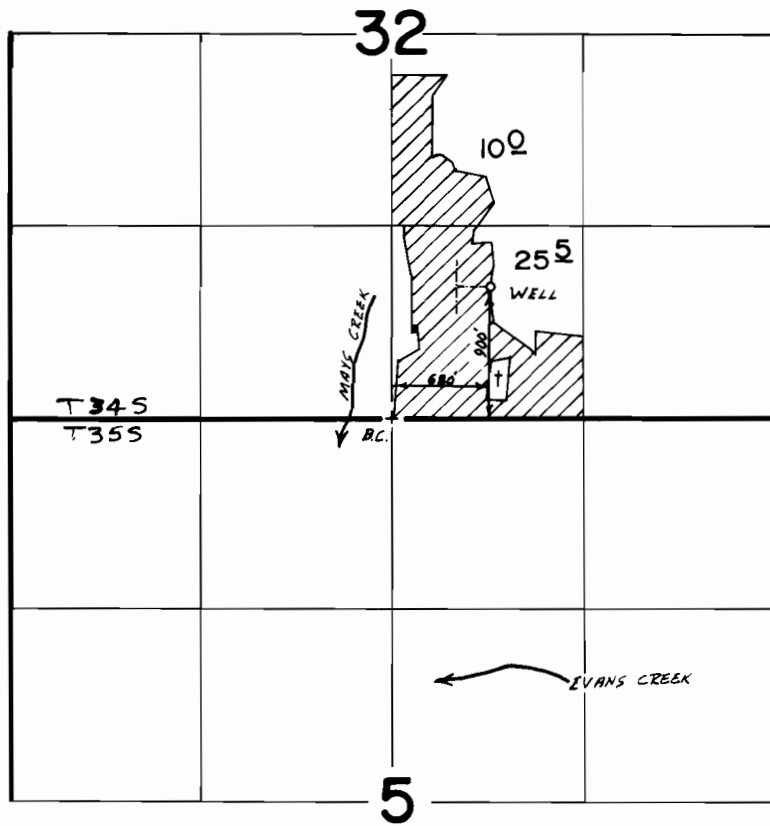

FINAL PROOF SURVEY UNDER

Application No. G-9148.. Permit No. G-8552...
IN NAME OF

CHARLES &/or JEANNE L. GREENLAW

Surveyed Sept. 15... 1981.., by B.R. SUND.....