


T. 34 S., R. 4 W., W.M.

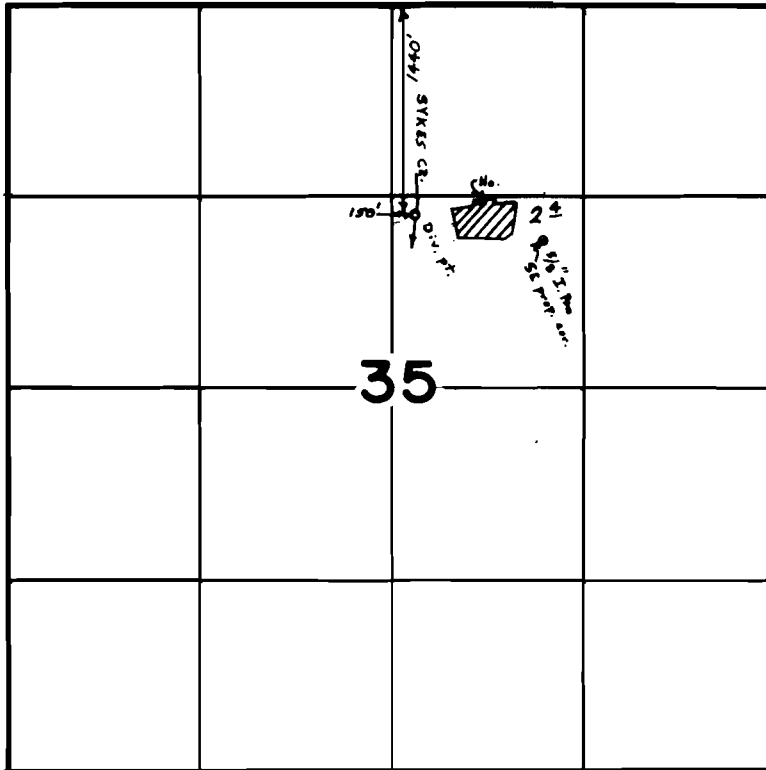

Scale 4" = 1 mile

FINAL PROOF SURVEY
UNDER

Application No. 52248. Permit No. 39323.....
IN NAME OF

ORVILLE...L...S...ARDELLE...K...CHURCHILL

Surveyed Sept. 17, 1980, by B.R. SUND.....