


# T. 33 S., R. 1 W., W.M.

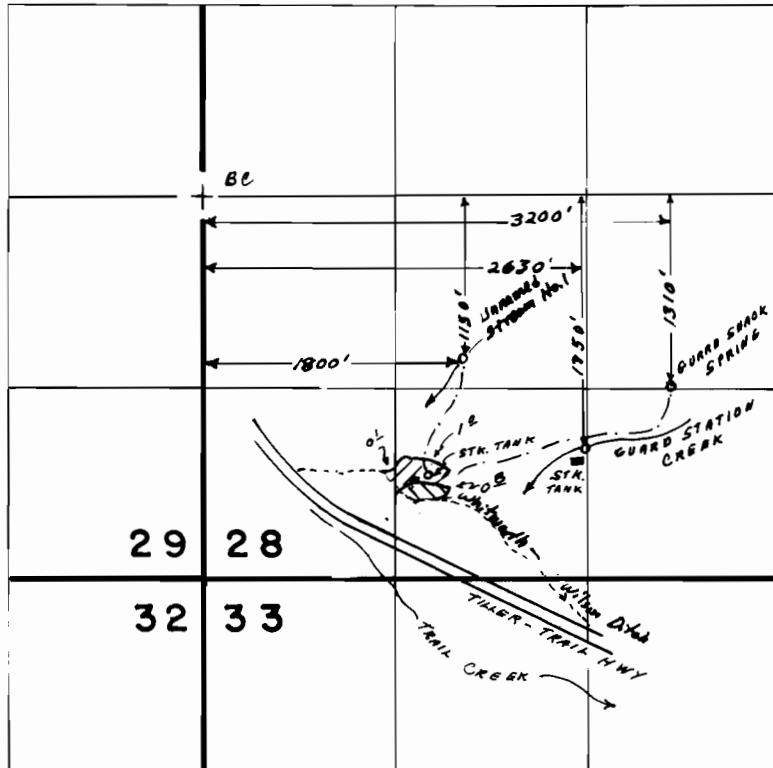

-  PERMIT 41121
-  PERMIT 43624

## FINAL PROOF SURVEY UNDER

54811                      41121

Application No. 5.7.9.7.8 Permit No. 4.3.6.2.4...  
IN NAME OF

DENTON D. & PATRICIA A. MC FARLIN

Surveyed SEPT. 11. 1985, by B. S. JAMES.