


T. 33 S., R. 1 W., W.M.

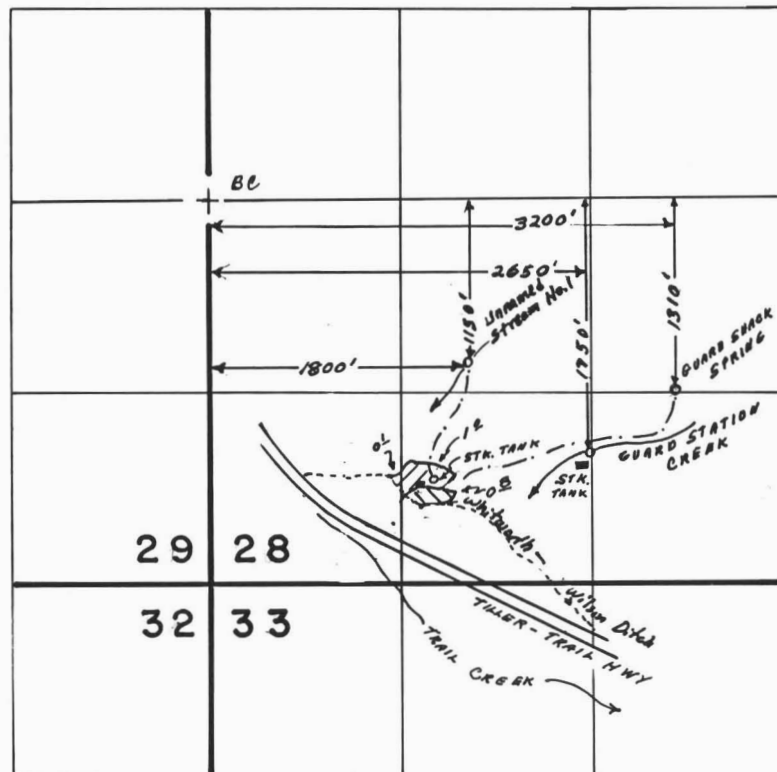

-  PERMIT 41121
-  PERMIT 43624

FINAL PROOF SURVEY
UNDER

54811 41121

Application No. 5.7.9.78 Permit No. 4.3.6.2.4...
IN NAME OF

DENTON, D. & PATRICIA A. MC FARLIN

Surveyed SEPT. 11, 1985, by B. S. JAMES.