


T. 34 S., R. 2 W., W. M.

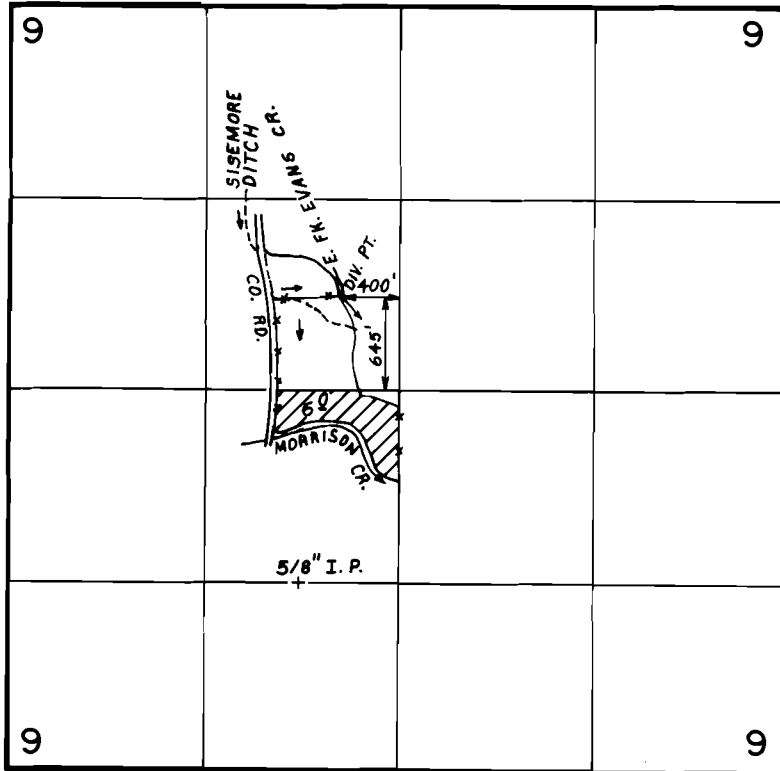

Scale: 4" = 1 MILE

FINAL PROOF SURVEY
UNDER

Transfer No. 3628
Application No. ~~55686~~ Permit No. 41714.....
IN NAME OF

GLENN E. & JOYCE S. ELLIS

Surveyed Sept. 10, 1982, by Bruce R. Sund