


T. 36 S., R. 4 W., W.M.

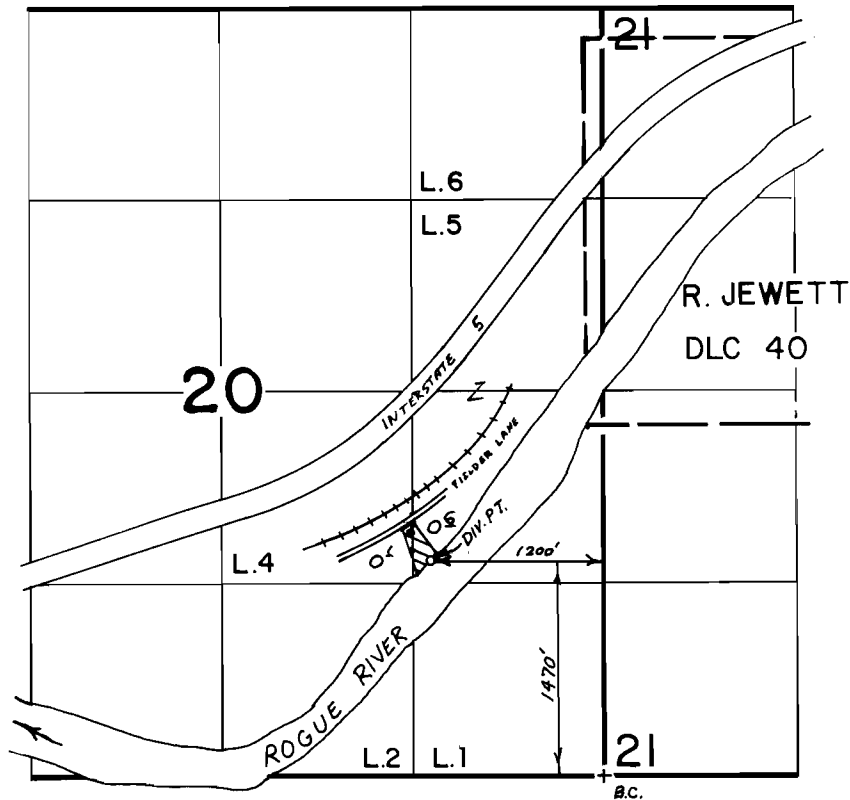

Scale : 4" = 1 Mile

FINAL PROOF SURVEY
UNDER

Application No. 56049. Permit No. 42272...
IN NAME OF

.....JOHN.....L.....FRINK.....

Surveyed Nov. 13, 1981, by Bruce R. Sund