


T.36 S., R.3 W., W.M.

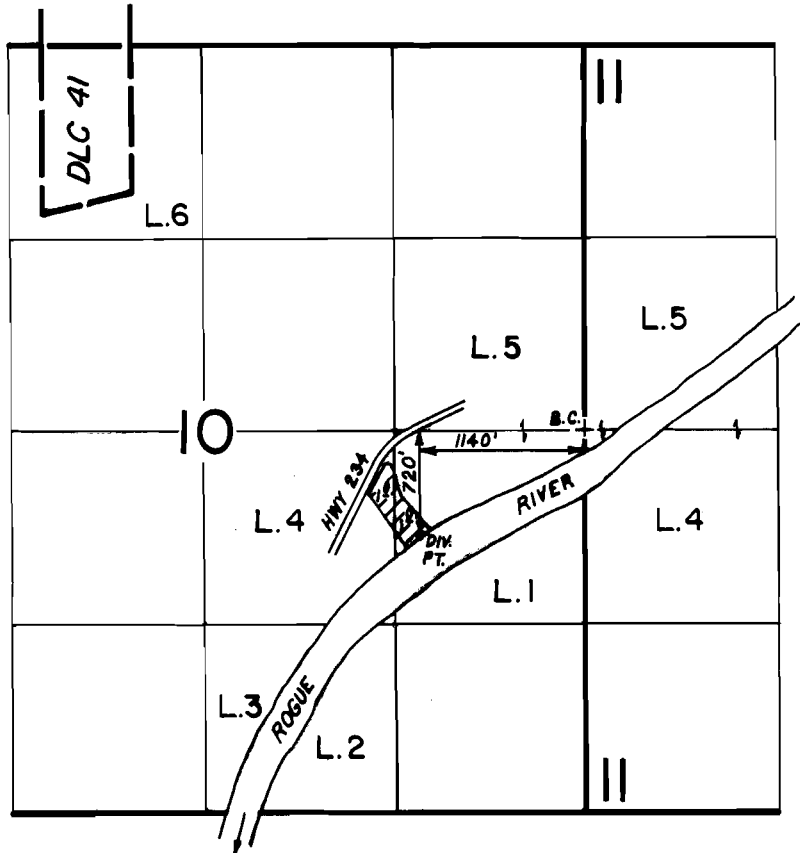

Scale: 4" = 1 mile

**FINAL PROOF SURVEY**  
UNDER

Application No. 56381... Permit No. 42362....  
IN NAME OF

JERRY E. MICHAEL

Surveyed Nov. 17, 1981, by Bruce R. Sund