


T. 37S., R. 3W., W.M.

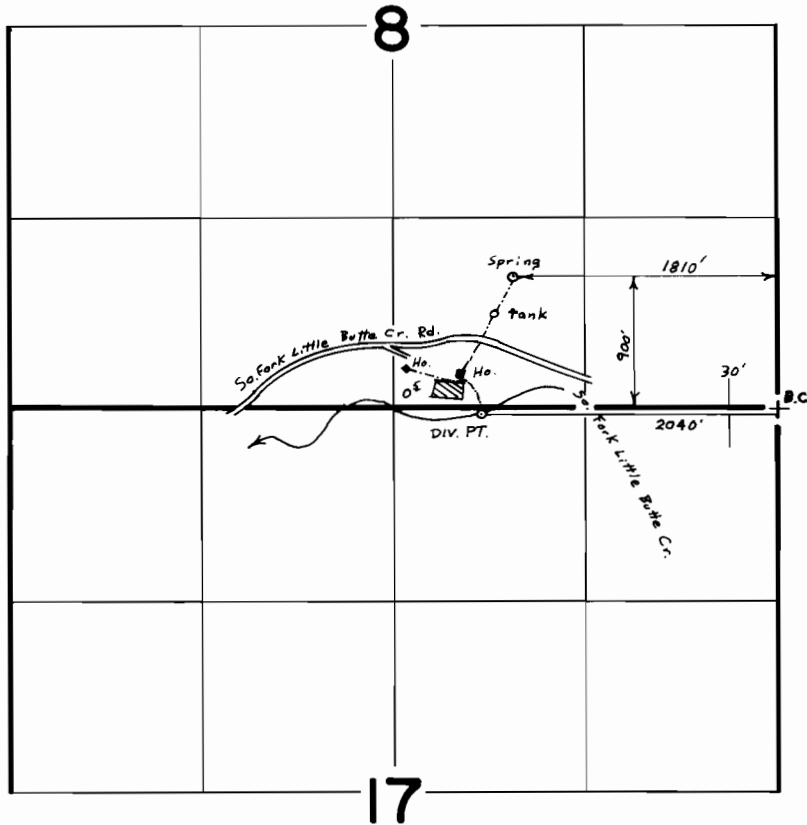

FINAL PROOF SURVEY
UNDER

Application No. 5572Q. Permit No. 42551.....
IN NAME OF

...UNITED.....BIBLE.....CHURCH.....

Surveyed FEB. 5., 1981., by Bruce R. Sund