


T. 33 S., R. 1 W., W. M.

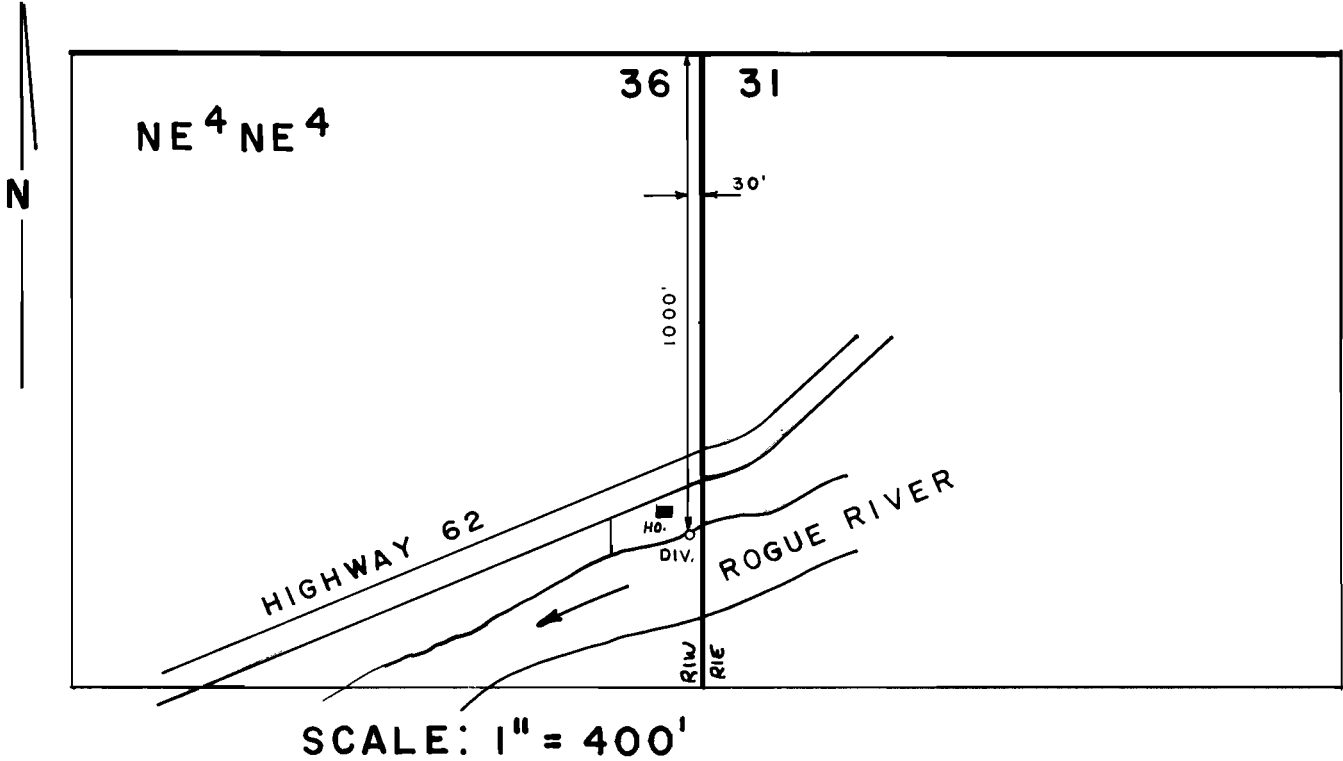

**FINAL PROOF SURVEY**  
UNDER

Application No. 57921, Permit No. 43670  
IN NAME OF

HAL A. & VIVIAN O. KENDALL JR.

Surveyed OCT. 15 1985, by B. S. JAMES  
MAY 30 1979 B. R. SLUND