


T. 40 S., R. 4 W., W.M.

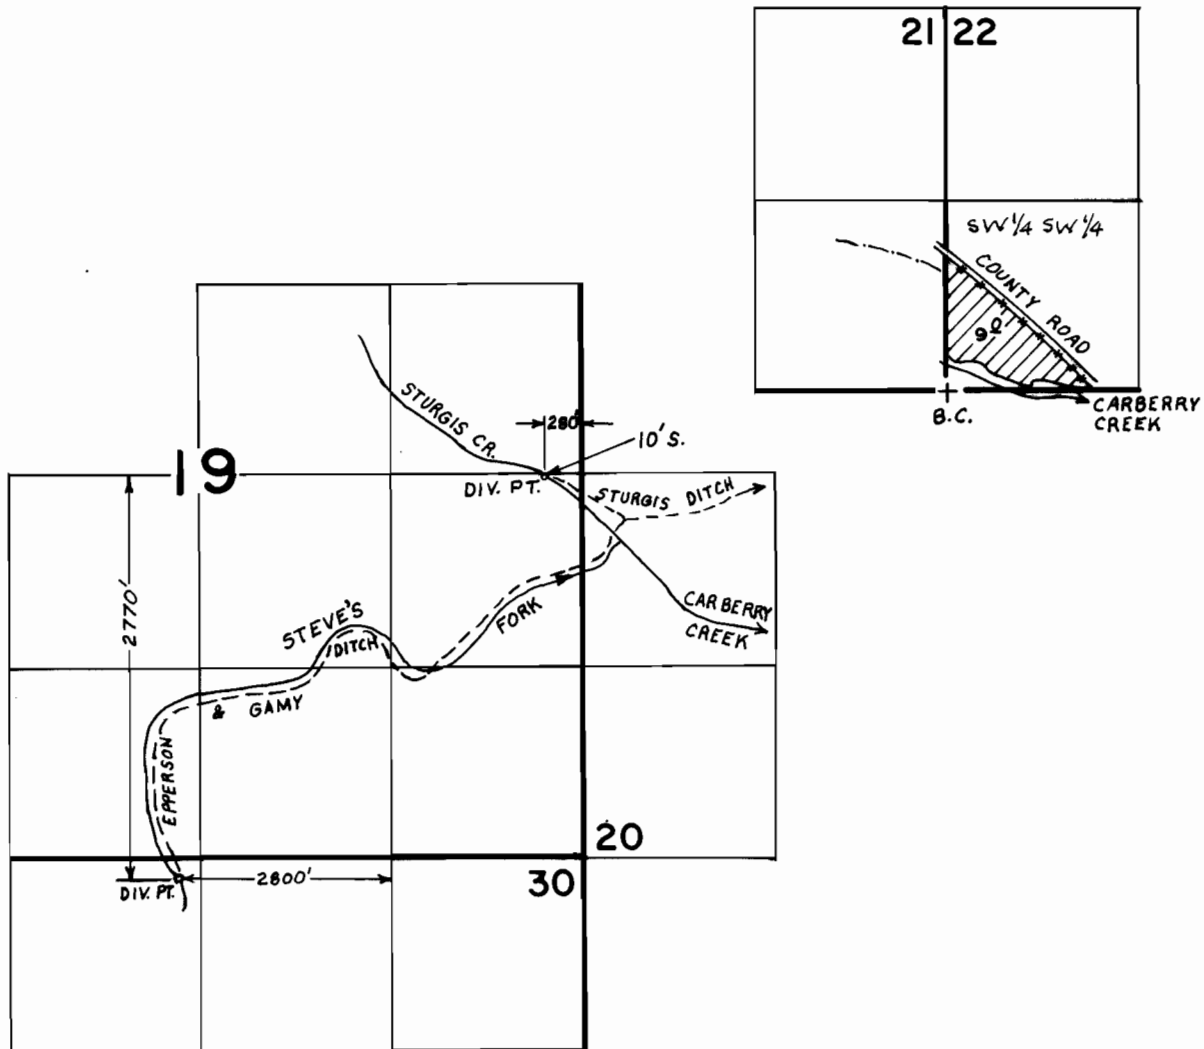

FINAL PROOF SURVEY
UNDER

Application No. 46948 Permit No. 43840
IN NAME OF

TRUMAN & ANNIE E. AUBREY

Surveyed JUNE 10, 1982, by BRUCE R. SUND

SCALE: 4" = 1 MILE