


Change in point of diversion.

Transfer No. T-4256

T. 38 S., R. 3 W., W.M.

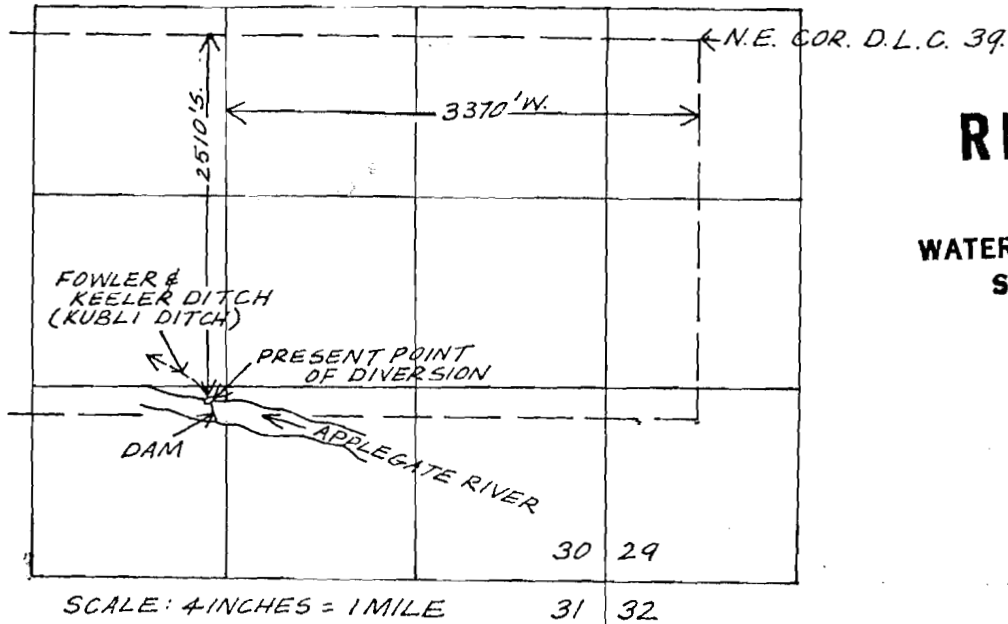


RECEIVED

AUG 3 1981

WATER RESOURCES DEPT
SALEM, OREGON

T. 38 S., R. 4 W., W.M.

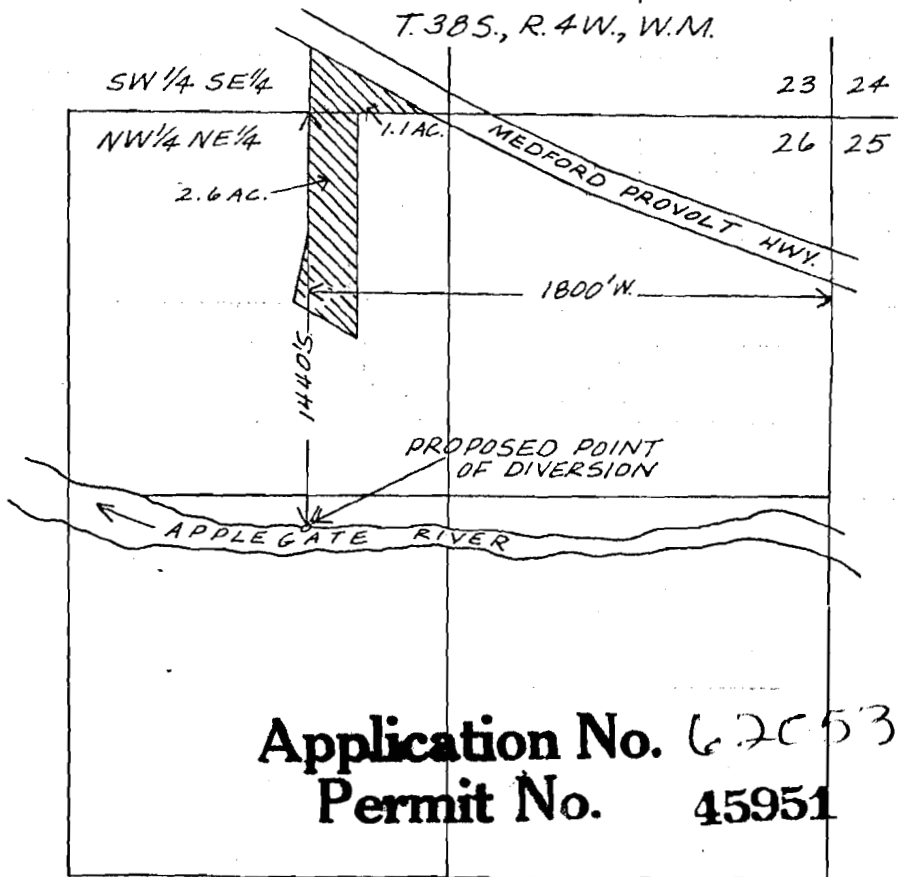

THIS MAP PREPARED BY:
Susan Richards
FROM INFORMATION FURNISHED BY
THE APPLICANT.



7-13-79

MAP TO ACCOMPANY APPLICATION OF
THOMAS J. AND GRACE M. SMITH FOR
CHANGE IN POINT OF DIVERSION FOR
CERT. 43988 - PRIORITY 1866.