


T. 36 S., R. 4 W., W.M.

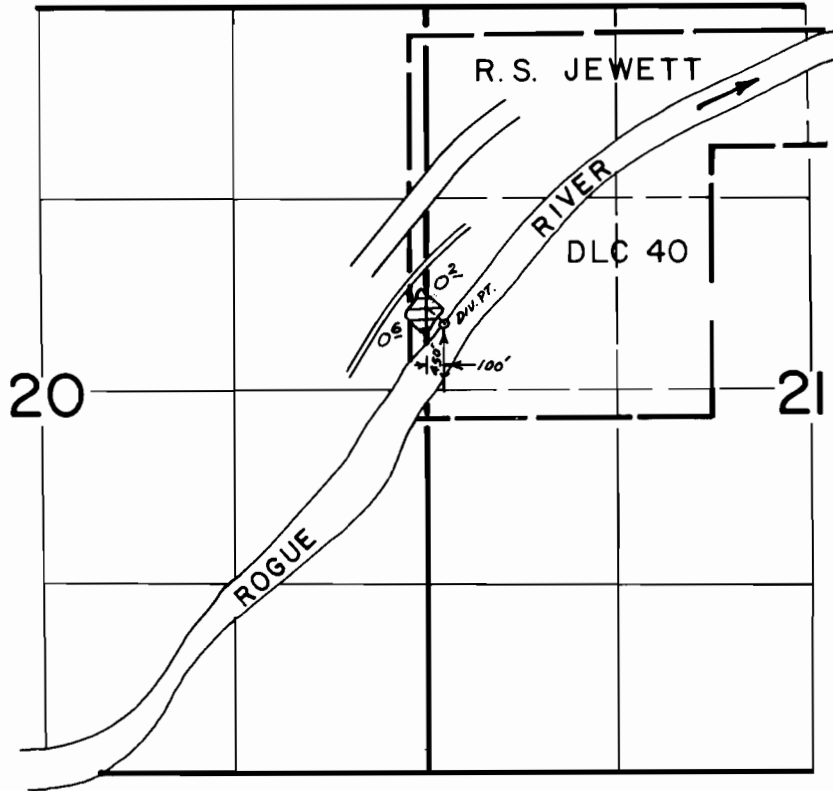

Scale: 4" = 1 Mile

**FINAL PROOF SURVEY**  
UNDER

Application No. 59707... Permit No. 44836.....  
IN NAME OF

.....RALPH.....M.....HATCH.....

Surveyed Nov. 13, 1981, by Bruce R. Sund...