


T.39 & 40S., R.3W., W.M.

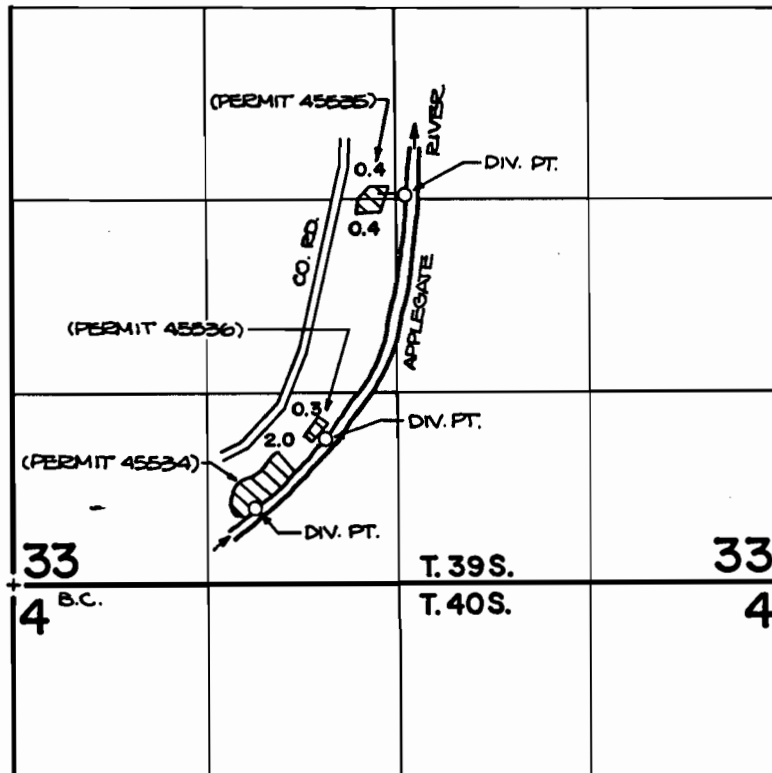

DIV. PT. (PERMIT 45535) LOC.: 2640' N. AND 2690' E.;
 DIV. PT. (PERMIT 45536) LOC.: 990' N. AND 2140' E.;
 DIV. PT. (PERMIT 45534) LOC.: 510' N. AND 1660' E.;
 ALL FROM THE S.W. CORNER OF SECTION 33.

FINAL PROOF SURVEY UNDER

60447 45536
 60446 45535

Application No. 60305. Permit No. 45534.....

IN NAME OF

LEE & MARGARET MYERS

Surveyed MAY 18 1982, by B. SUND