


T. 38 S., R. 4 W., W.M.

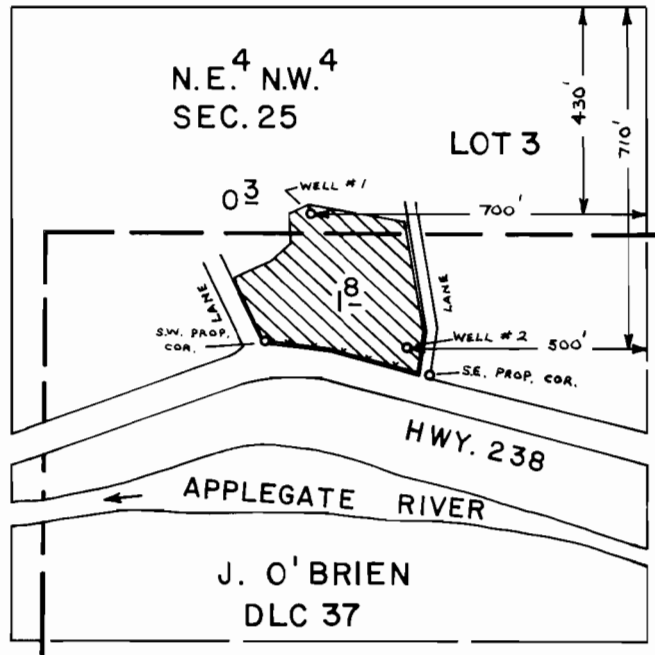

SCALE : 1" = 400 FT.

**FINAL PROOF SURVEY**  
UNDER

Application No. G-6973 Permit No. G-6482  
IN NAME OF

EVAN H. &/OR SARAH B. OWENS

Surveyed APR. 5 1979, by B. SUND

D.H.M.  
P.T.S. - 1979 - 14 - A