


T. 38 S., R. 4 W., W.M.

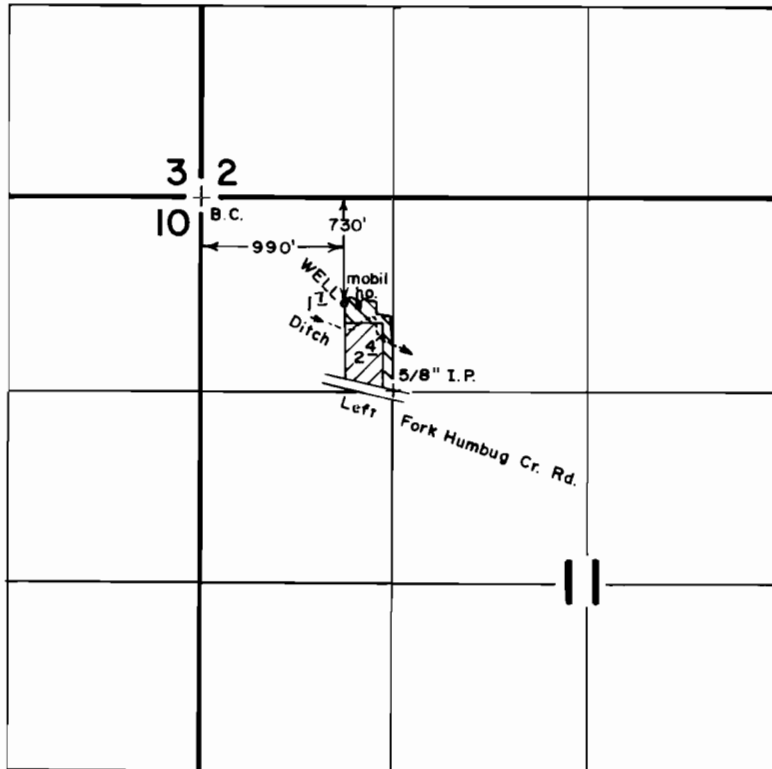

FINAL PROOF SURVEY
UNDER

Application No. G-8841 Permit No. G-8273
IN NAME OF

JOHN R. &/or BEVERLY G. WILLOUGHBY

Surveyed JUNE 23 1982, by BRUCE R. SUND

SCALE: 4" = 1 MILE

- PRIMARY
- SUPPLEMENTAL