


# T.38S. R.4W. W.M.

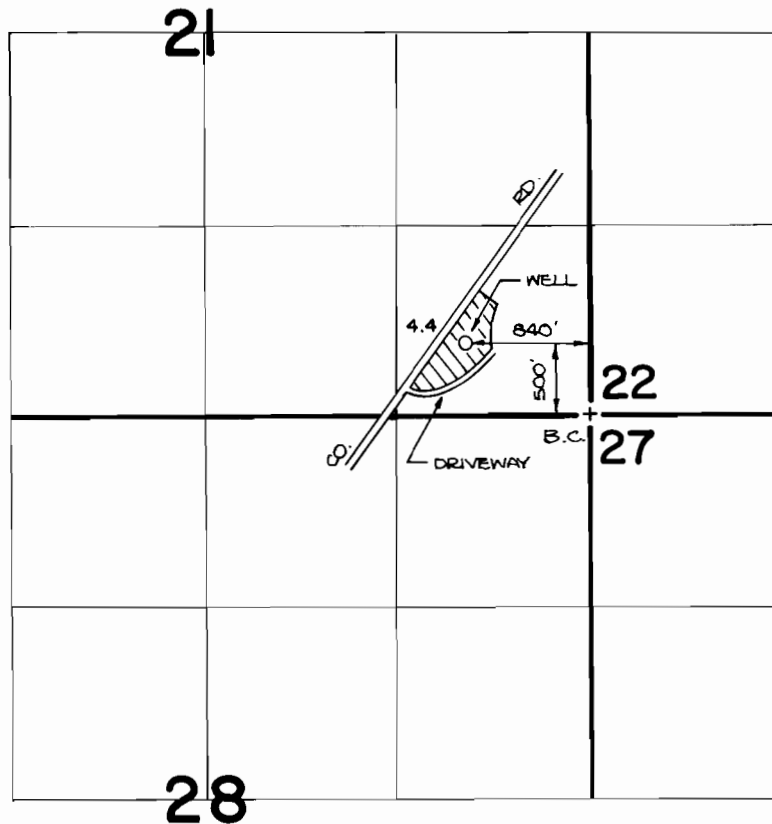

## FINAL PROOF SURVEY UNDER

Application No. G-10105. Permit No. G-9563.....  
IN NAME OF

**C.H. & RUTH A. HERMAN.**

Surveyed **JUNE 9**, 1982., by **B. SUND**.....