


T. 37 S., R. 3 E., W.M.

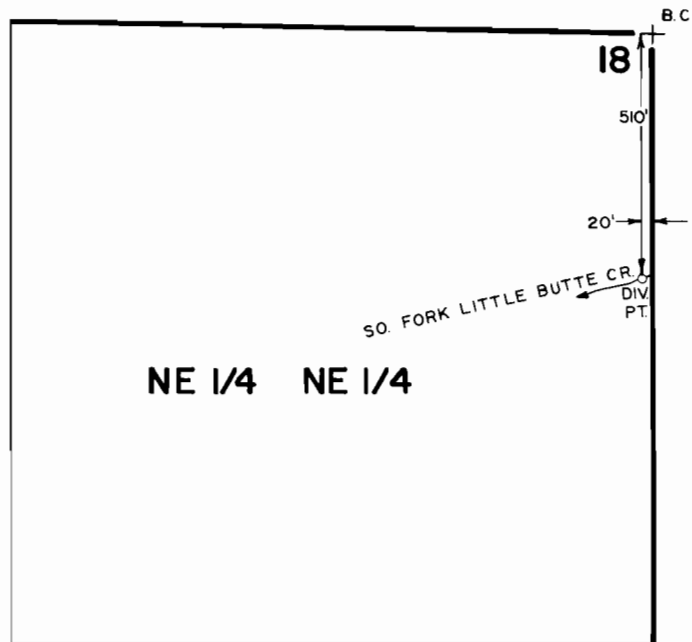

**FINAL PROOF SURVEY**  
UNDER

TRANSFER NO. 2915

Application No. .... Permit No. ....

IN NAME OF

**H. ROBERT GILKEY, & LOREN D. & LAURA L. RUSH**

Surveyed **JULY 29 19.82**, by **B. SUZIE JAMES**.

SCALE: 1" = 400'