


T.38S., R.4W., W. M.

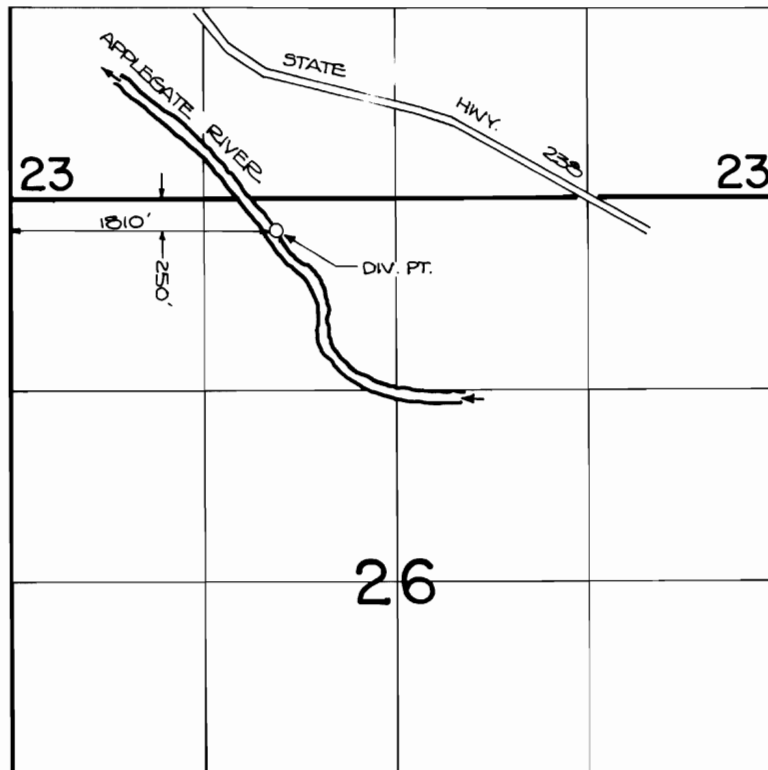

FINAL PROOF SURVEY
UNDER

TRANSFER NO. 5113

IN NAME OF

LAWRENCE E. & NORMA G. HOYT

Surveyed **JULY 14 1983**, by **B. JAMES**