


T. 37S., R. 8W., W.M.

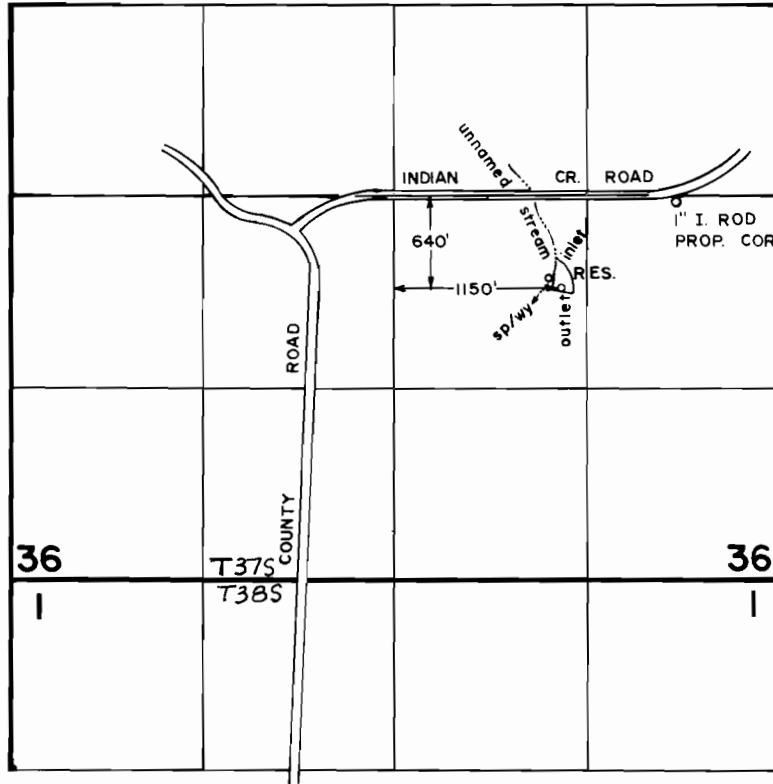

FINAL PROOF SURVEY
UNDER

Application No. R-44175 Permit No. R-5097
IN NAME OF

ART. STRAIGHT

Surveyed OCT. 25, 19.83, by B. S. JAMES

SCALE: 4" = 1 MILE