


T. 34 S., R. 5 W., W.M.

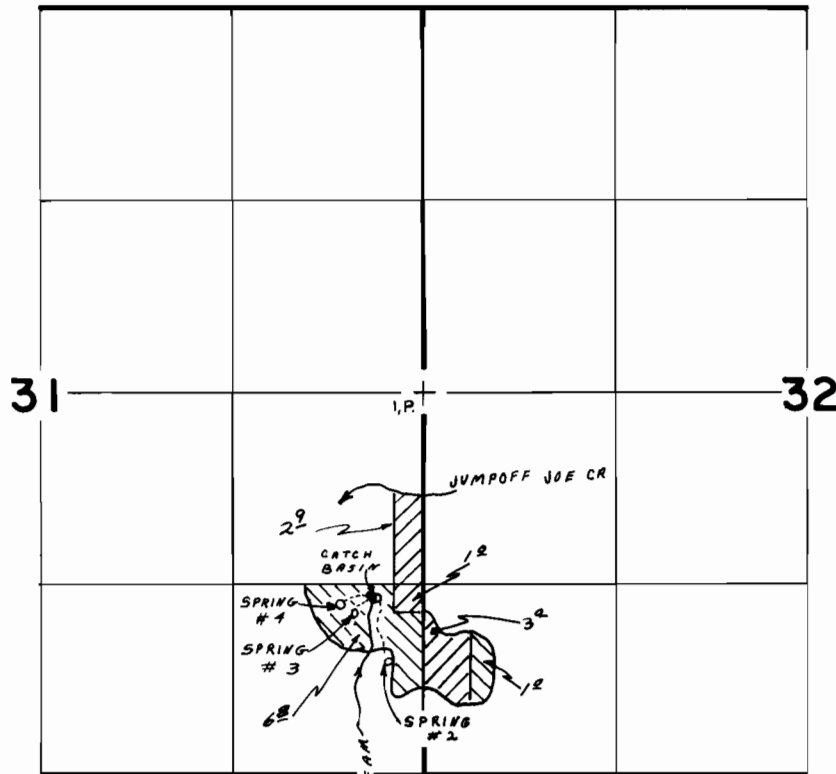

SCALE:
1" = 1320'

DIVERSIONS:

- (1) Unnamed Stream = 1450' S., 350' W.;
- (2) Spring = 1850' S., 260' W.;
- (3) Spring = 1500' S., 470' W.;
- (4) Spring = 1450' S., 575' W.;

From E. 1/4 Cor. Sec. 31

PRIMARY =



SUPPLEMENTAL =



FINAL PROOF SURVEY UNDER

Application No. 64424 Permit No. 47421....
IN NAME OF

ARNOLD A. & CATHERINE PITTS

Surveyed JUL 12, 1985, by B. S. JAMES..