


T.34-35 S. R.5 W.W.M:

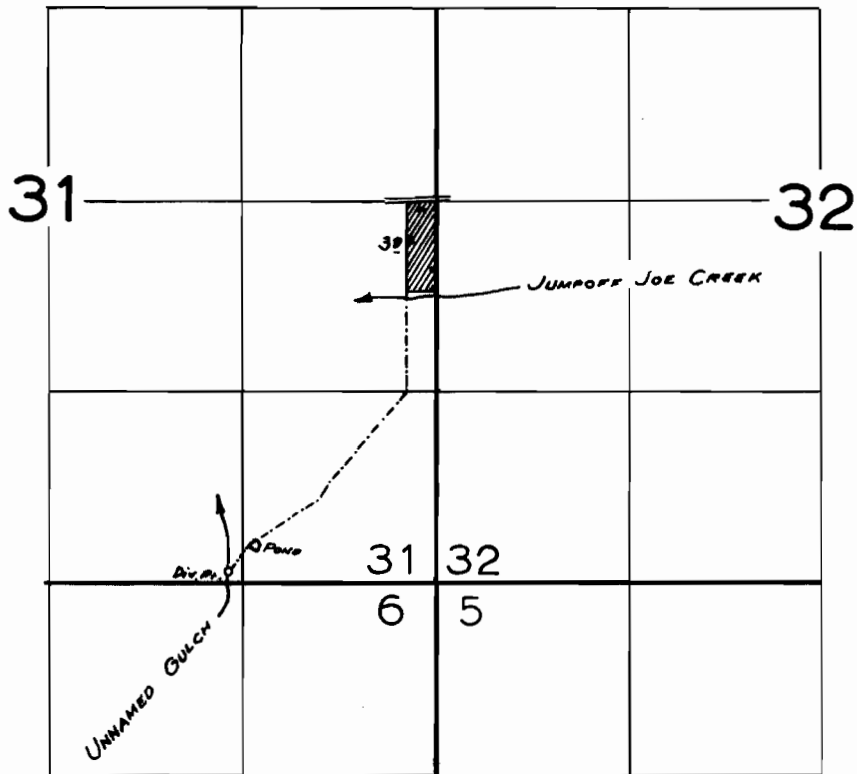

**FINAL PROOF SURVEY**  
UNDER

Application No. 30047 Permit No. 23692  
IN NAME OF

*CARL HUSEN*

Surveyed July 16 1959, by *R. Jackson*