


# T. 37 S., R. 7 W., W.M.

for G-3228:

|||| supplemental

//// primary

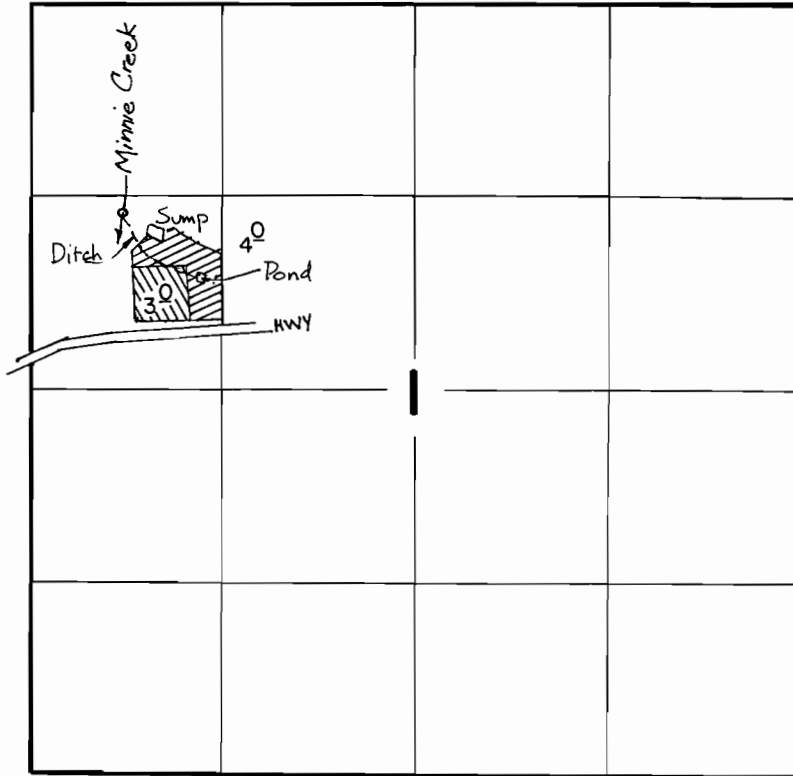

MINNIE CREEK Div. Pt. 120' S. & 680' W.  
 SUMP Div. Pt. 240' S. & 450' W.  
 POND Div. Pt. 560' S. & 150' W.  
 All located from N.E. Cor. S.W. 1/4 N.W. 1/4 Sec. 1.

## FINAL PROOF SURVEY UNDER

41355 30892

Application No. ~~G.3228~~ Permit No. ~~G.3036~~....  
 IN NAME OF

.....Robert and Jean Sweet.....

Surveyed AUG. 13, 1982, by B. S. JAMES.....