


T. 35 S., R. 7 W., W.M.

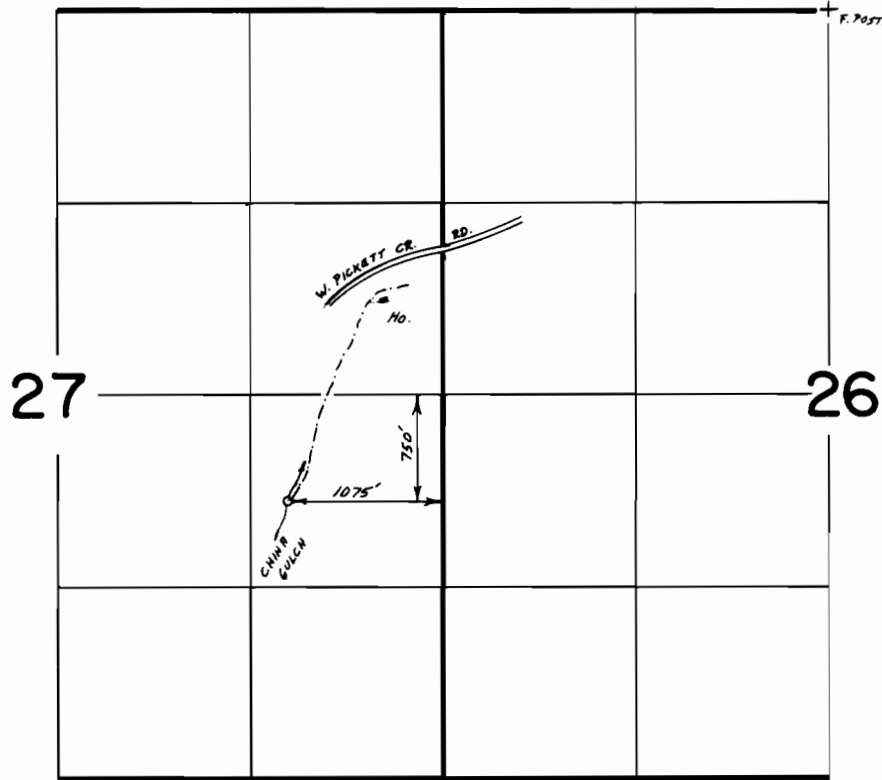

Scale 1" = 1320'

FINAL PROOF SURVEY
UNDER

Application No. 55266. Permit No. 41422.....
IN NAME OF

.....*MARY G. THOMAS et al.*.....

Surveyed Oct. 22, 1985, by B.S. JAMES.....