


T. 39S., R. 8W., W.M.

Sec. 28

NE 1/4 SE 1/4

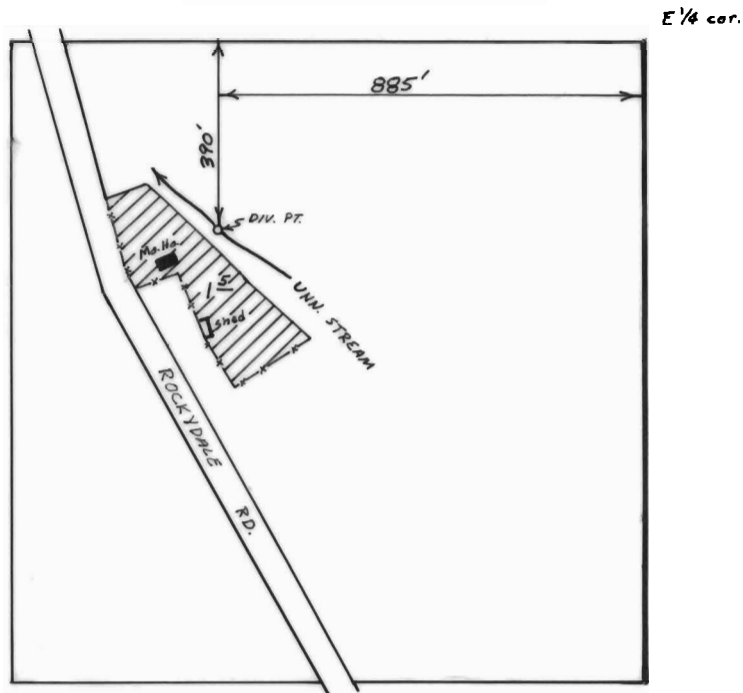

Scale 1" = 400'

FINAL PROOF SURVEY

UNDER

Application No. 58526 Permit No. 44284
IN NAME OF

WALTER L. & ETHEL L. CAMPBELL

Surveyed April 30, 1980, by B. R. SUND