
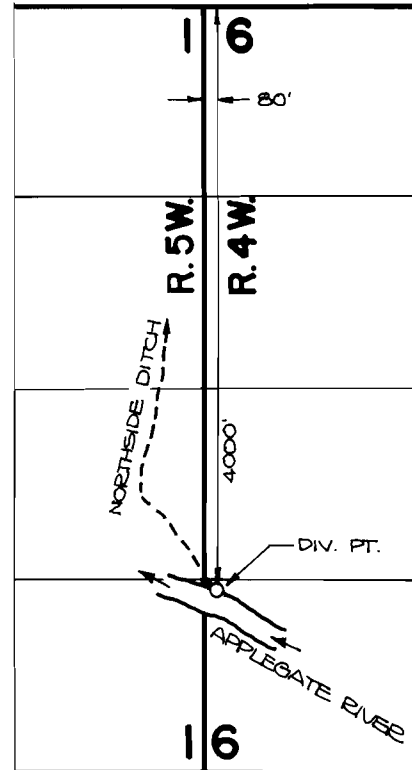


T. 37S., R. 5W., W. M.

T. 38S., R. 4 & 5W., W.M.

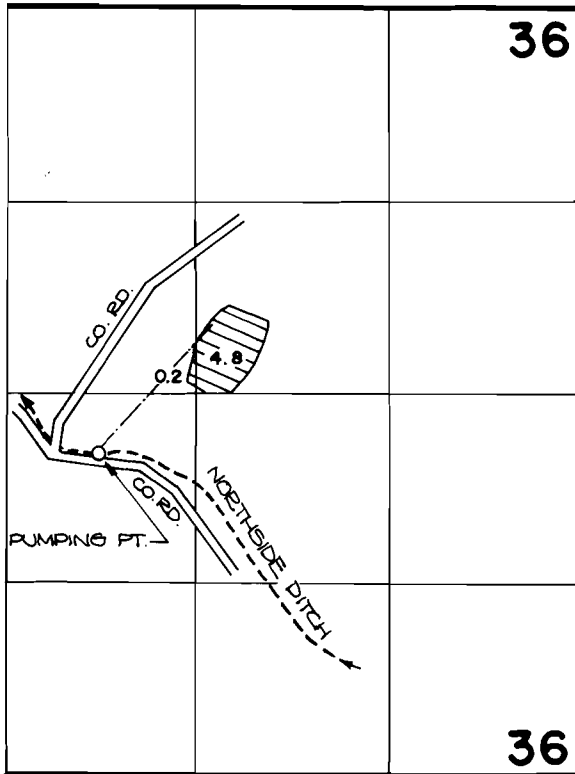

FINAL PROOF SURVEY
UNDER

Application No. **61894** Permit No. **45884**
58813 **44328**
IN NAME OF

R. B. HODGE

Surveyed **AUG. 18, 1983**, by **B. JAMES**