


T. 37 S., R. 6 W., W.M.

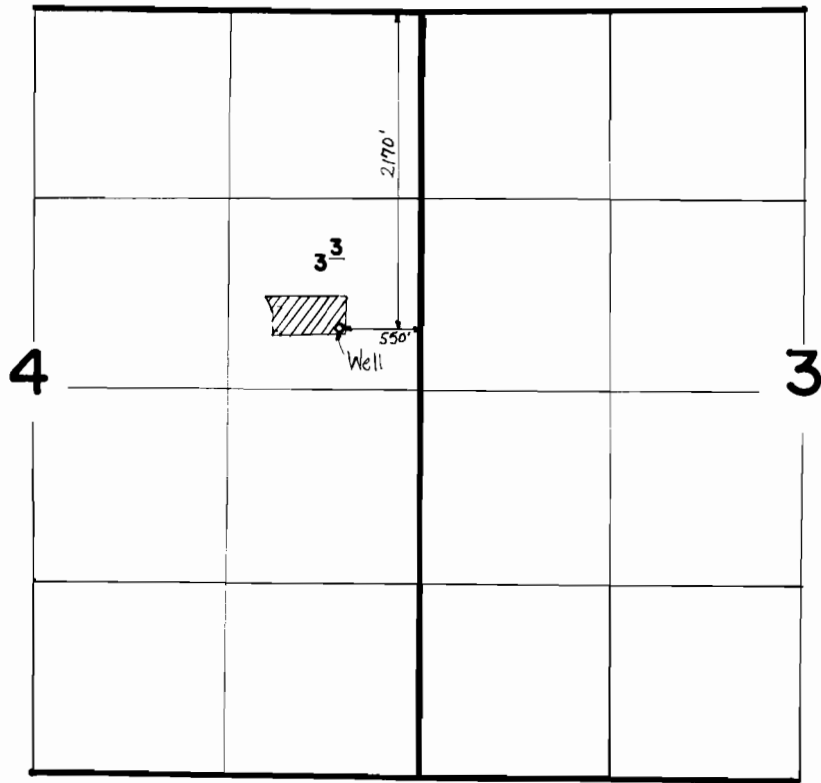

**FINAL PROOF SURVEY**  
UNDER

Application No. G. 7955 Permit No. G. 7395.....  
IN NAME OF

**SIGNE M. &/OR BONNEY M. CARLSON**

Surveyed AUG...11,.. 1982., by ..B..S..JAMES.....