

Form AI-187
March 1961

UNITED STATES
DEPARTMENT OF THE INTERIOR
BUREAU OF LAND MANAGEMENT

RECEIVED
OCT 13 1964
STATE PLANT


SECTION

4

Oregon State Water Filings

TOWNSHIP 11S, RANGE 43E, W. M.

North

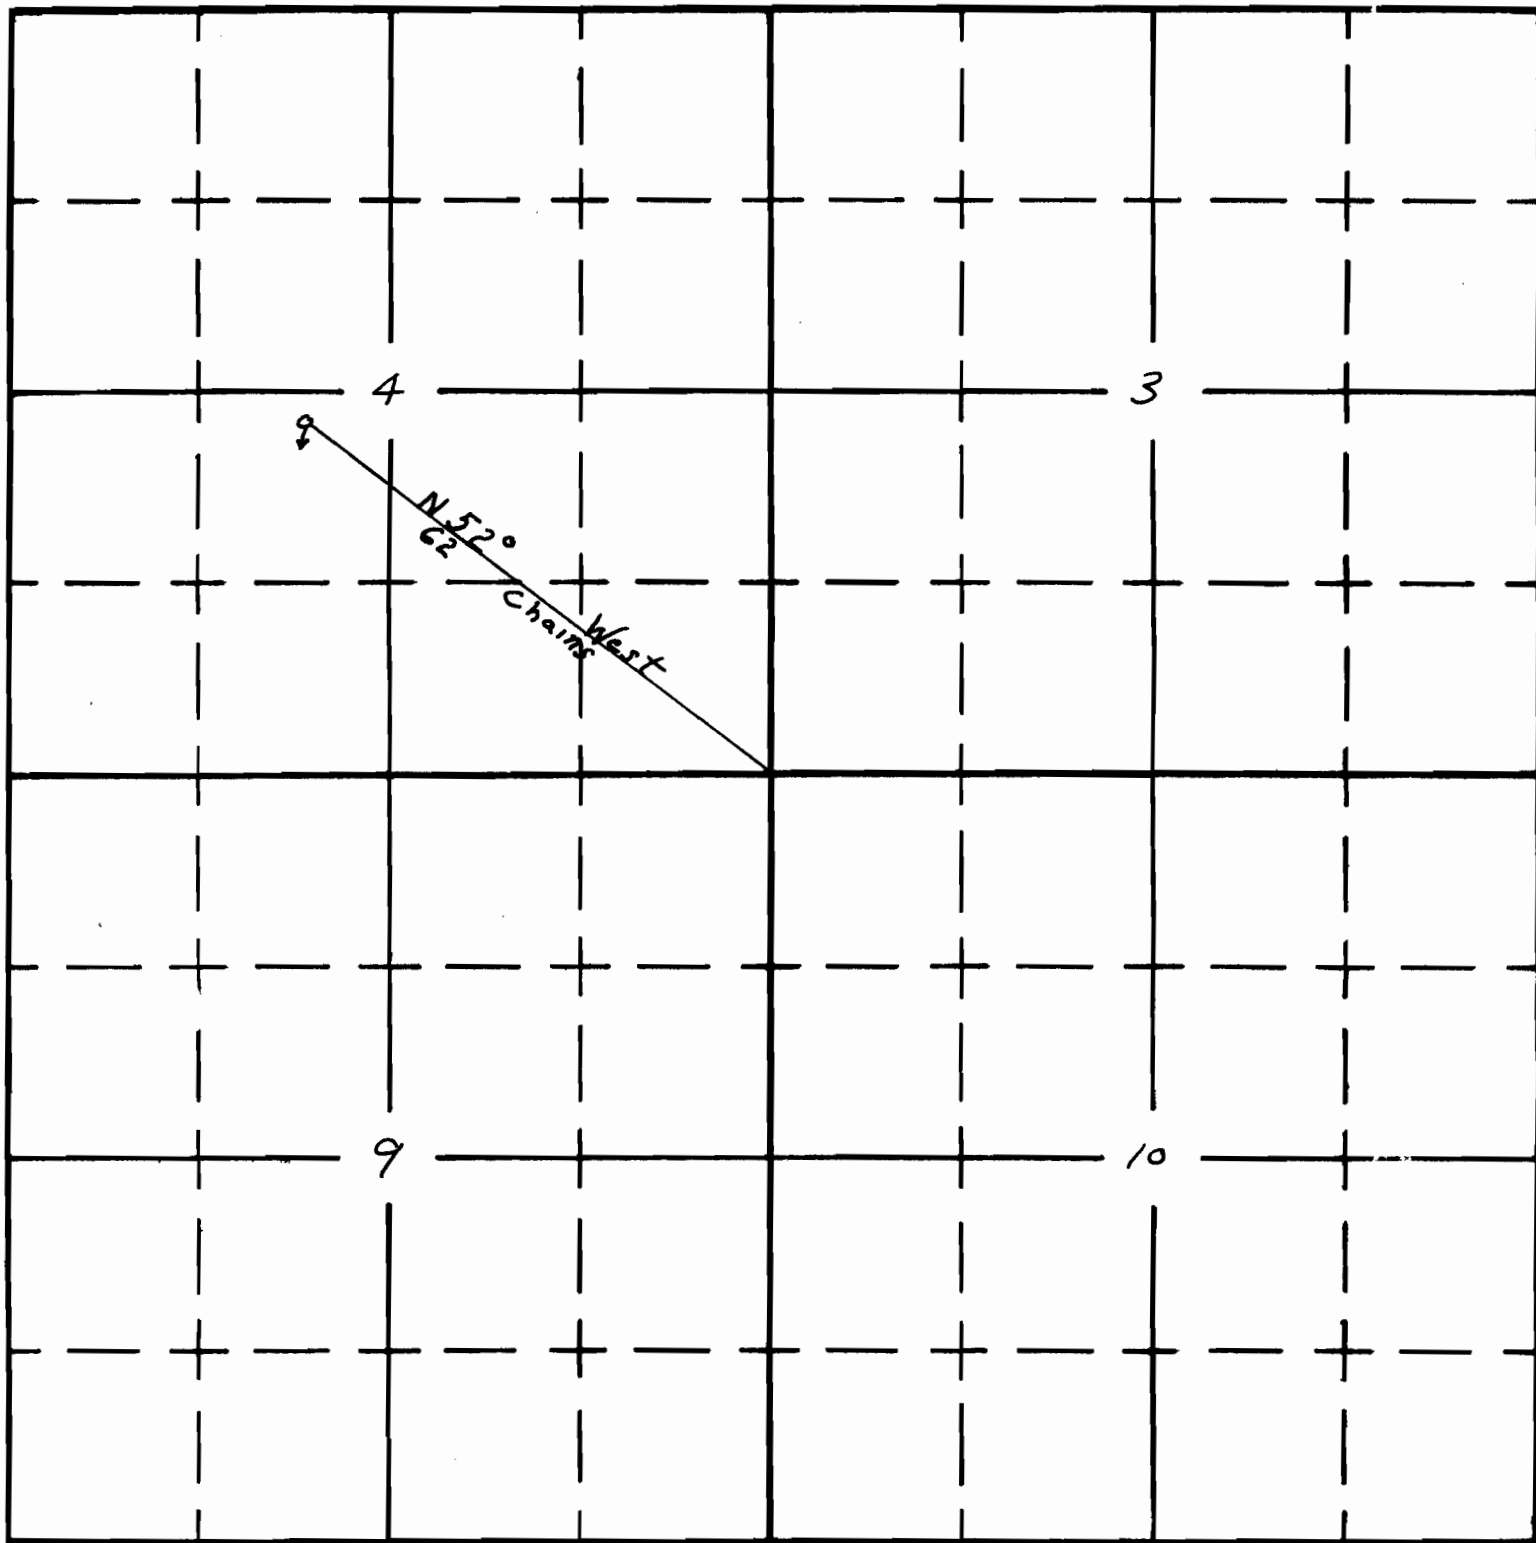

South

APPLICATION No. 40373


PERMIT No. 30261

4-1216
(JUNE, 1952)

UNITED STATES
DEPARTMENT OF THE INTERIOR
BUREAU OF LAND MANAGEMENT

Iron Mtn. Water Development

TOWNSHIP 11S, RANGE 4SE, W1/4 MER.
STATE Oregon

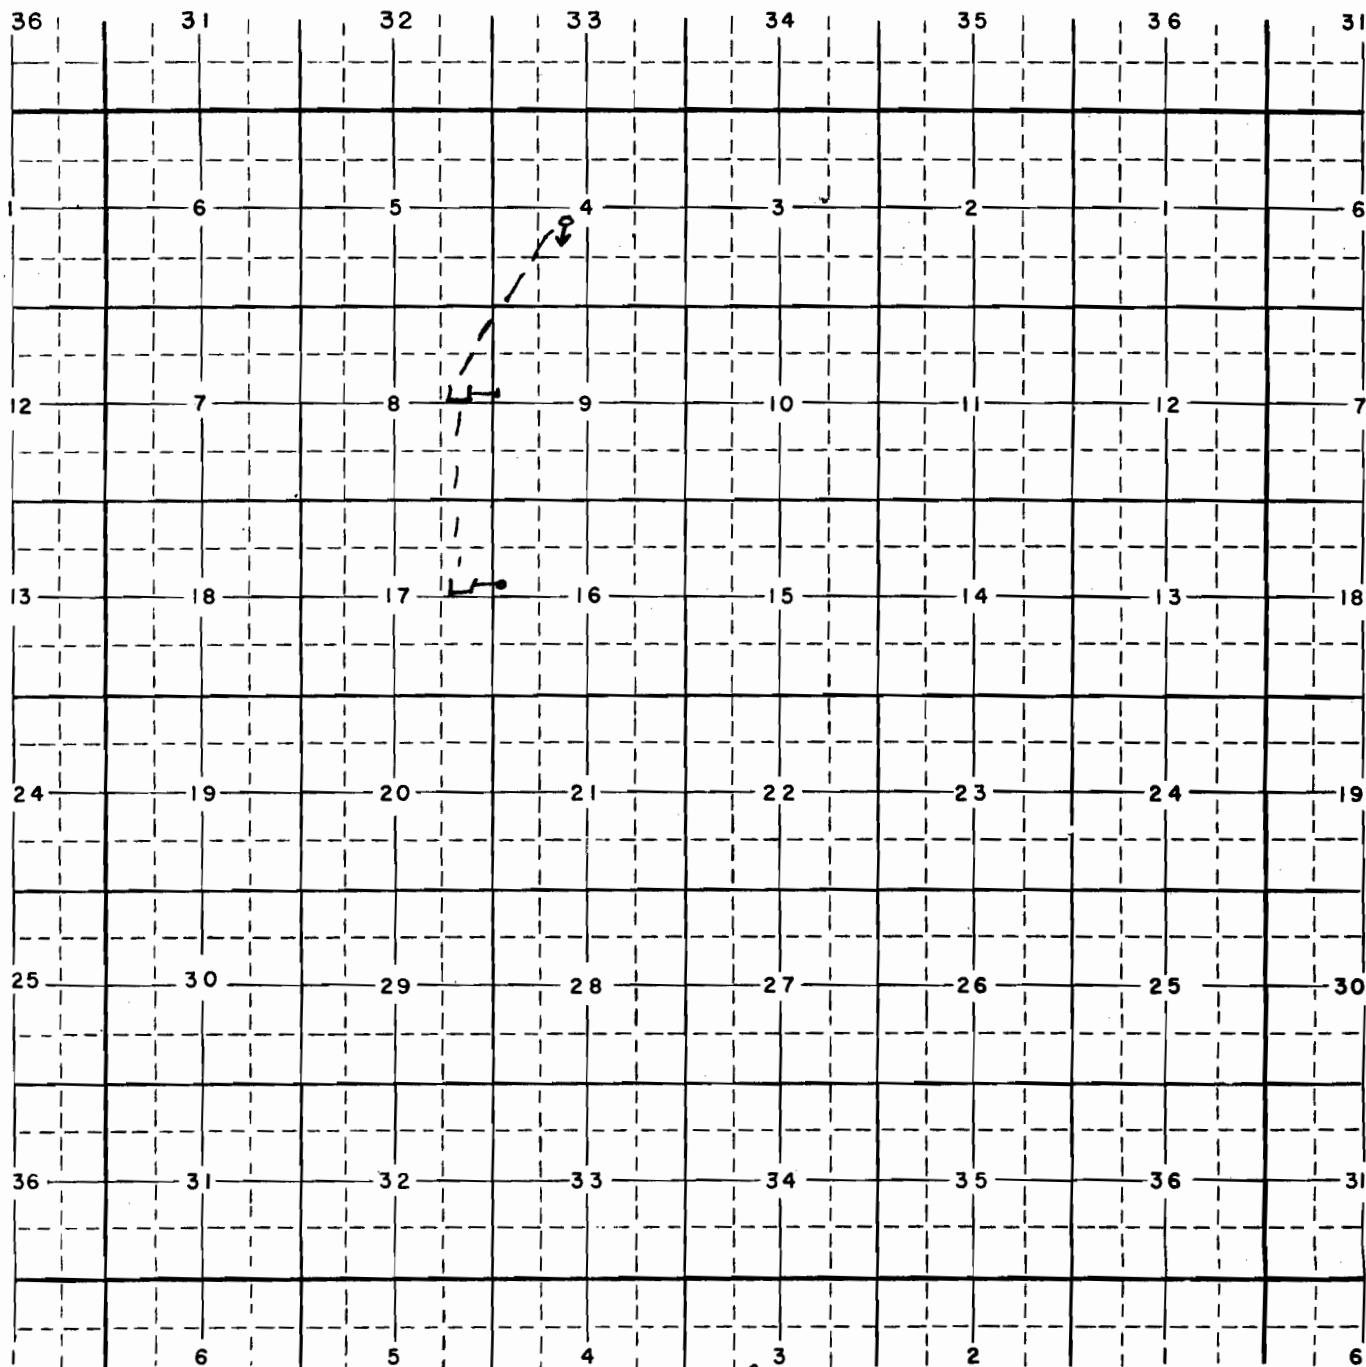

or prepared spring development
or prepared trough
or prepared pipeline
Application No. 40373
Permit No. _____

RECEIVED
OCT 13 1964
STATE ENGINEER
CLERK