


T. 8S., R. 38E., W. M.

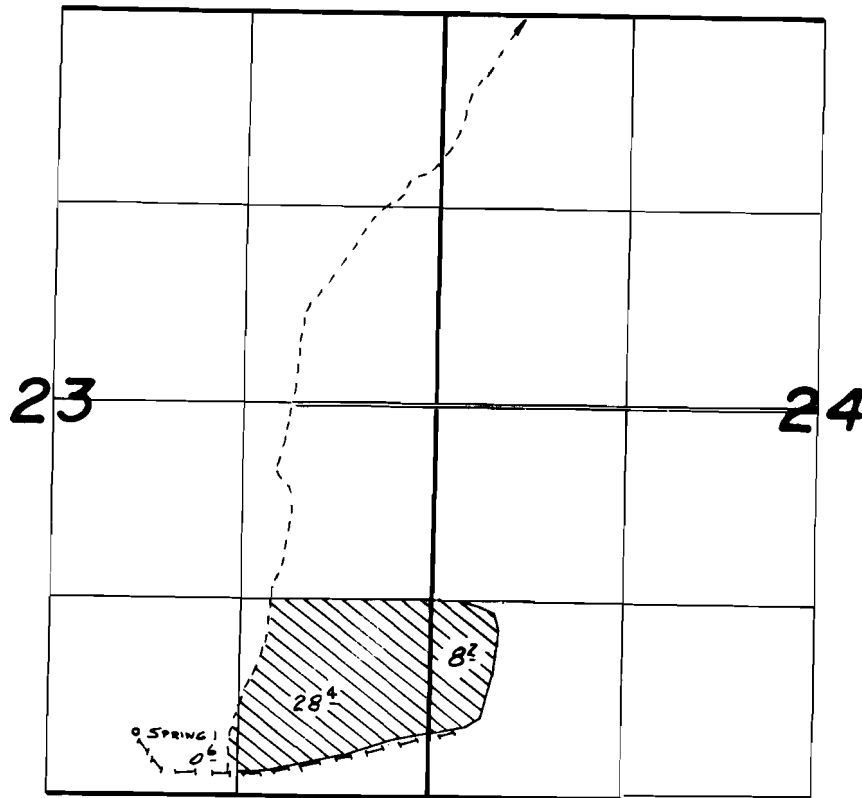

SPRING 1 410' N. & 2000' W. FROM SE COR. SEC. 23

FINAL PROOF SURVEY
UNDER

Application No. **57110** Permit No. **42943**
IN NAME OF

HARRY A. PHILLIPS

Surveyed **Aug. 16** 19**88**, by **J. L. Church**