




RECEIVED
MAY 28 1964
WATER RESOURCES DEPT
SALEM, OREGON

MAP OF WATER SYSTEM

T.6N. R.10W. SECTION 33

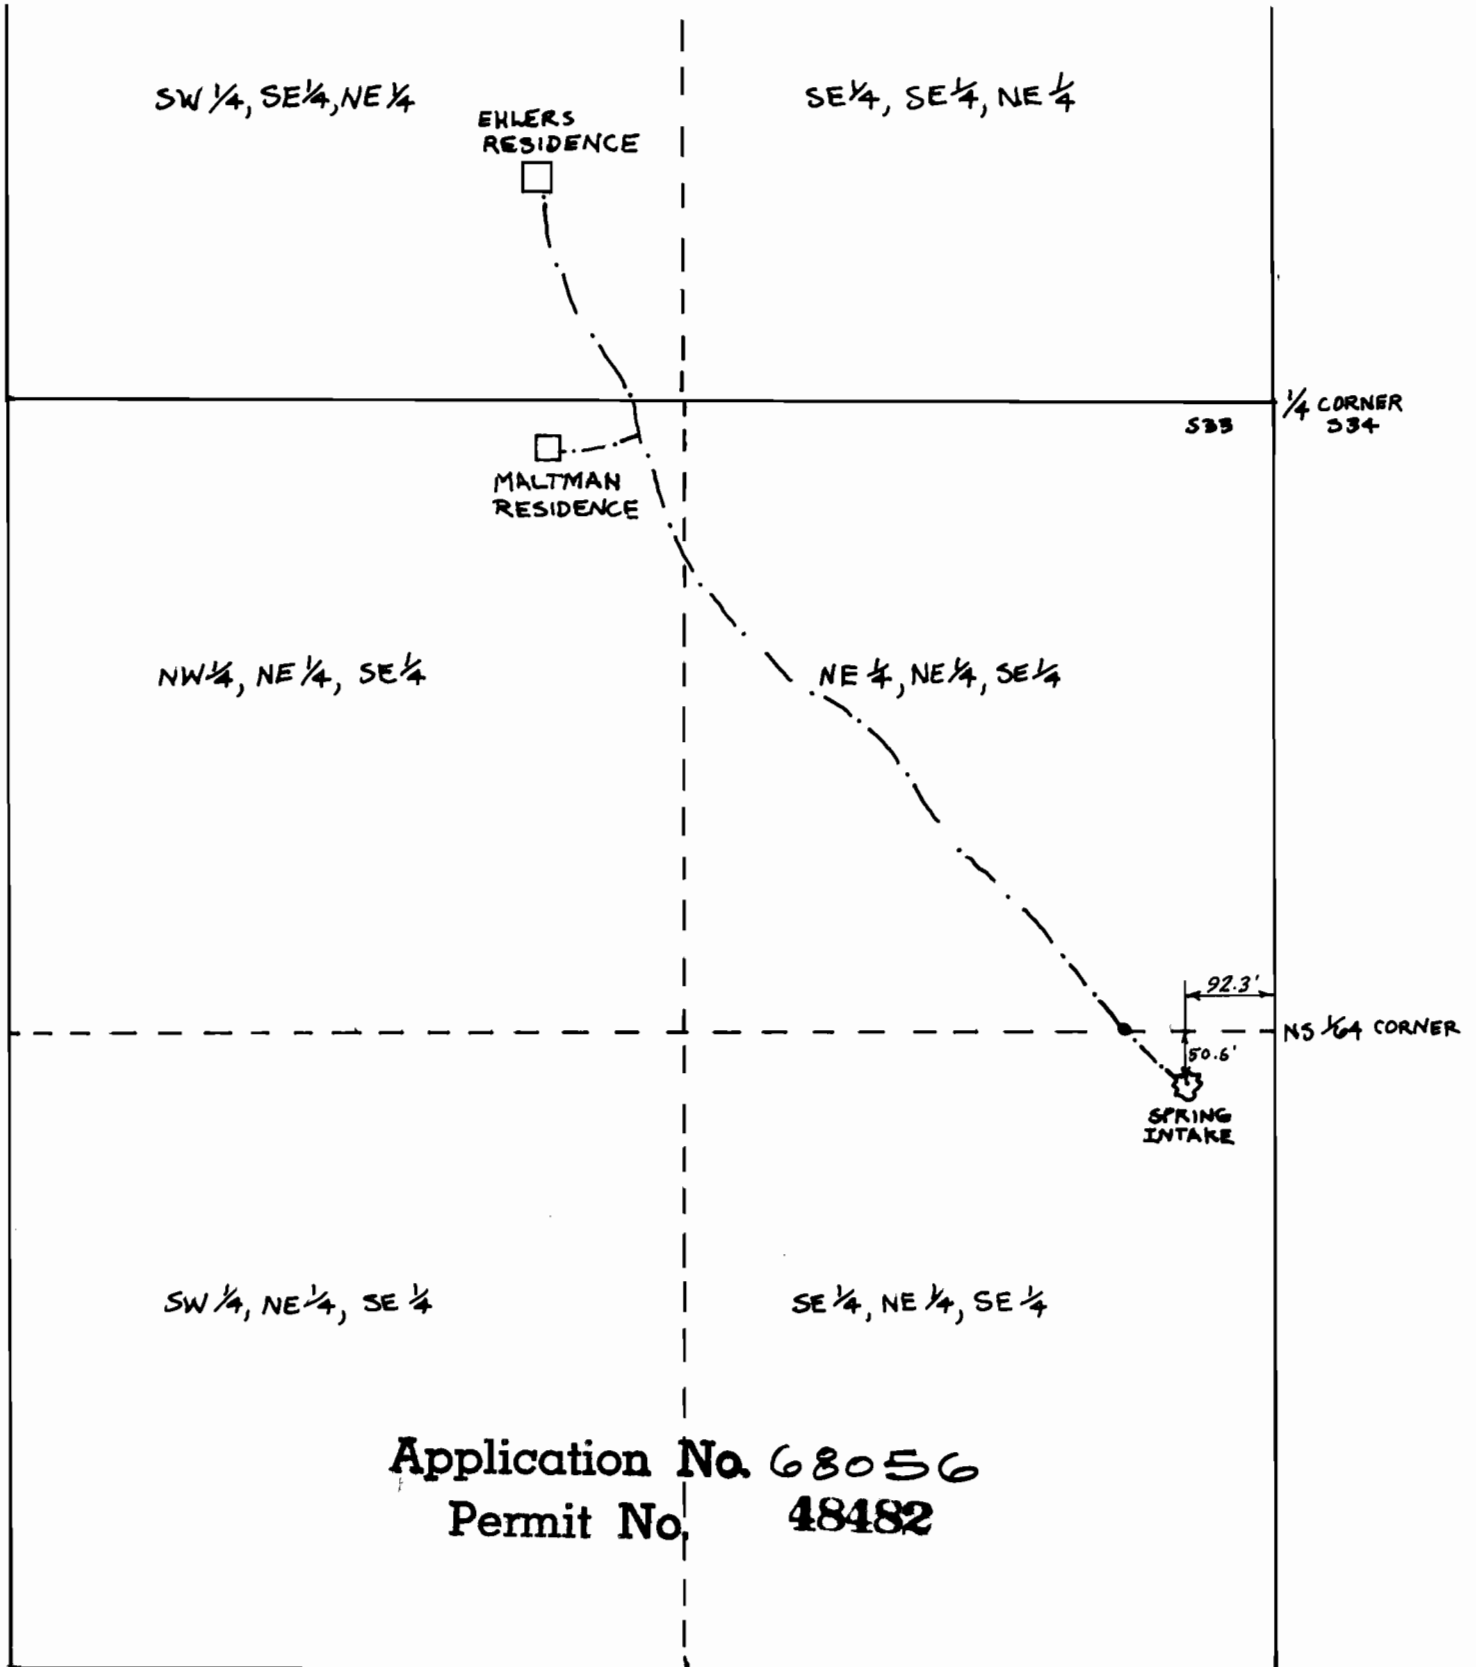

SCALE = 1" = 200'