


T. 13S., R. 29E., W.M.

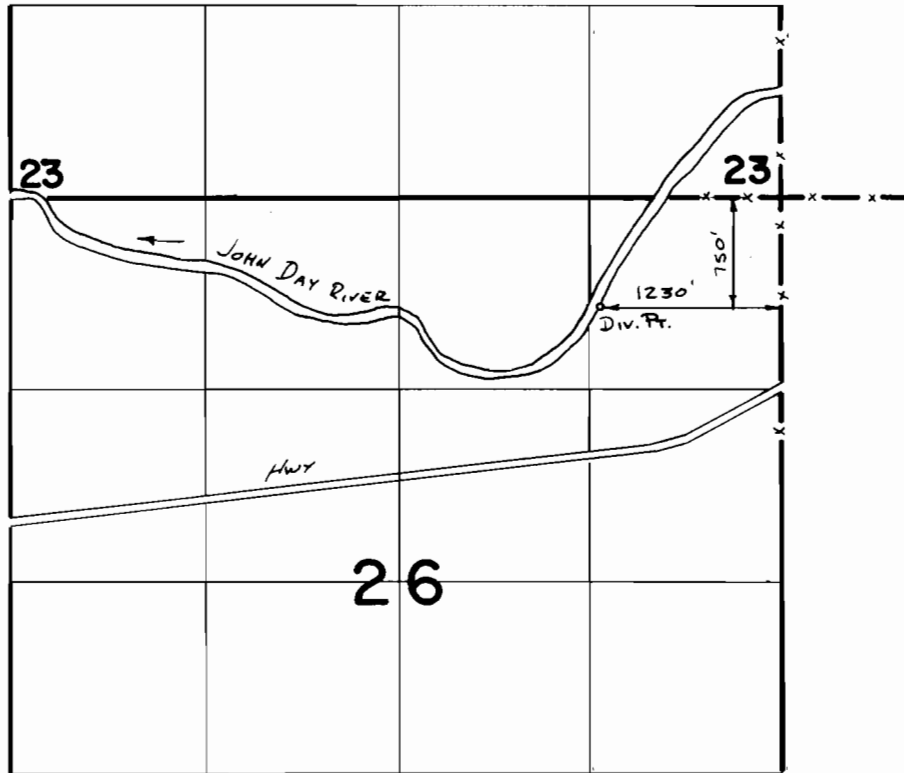

SCALE 1" = 1320'

FINAL PROOF SURVEY
UNDER

TRANSFER 5758
IN NAME OF

HOMER L. HARRISON

Surveyed ... 6-19 ... 1988, by *V. L. Church*