

UNITED STATES  
DEPARTMENT OF THE INTERIOR  
BUREAU OF LAND MANAGEMENT

SECTION



NW 1/4 SE 1/4

TOWNSHIP 23S, RANGE 27E, W. M.

Sec. 12

North

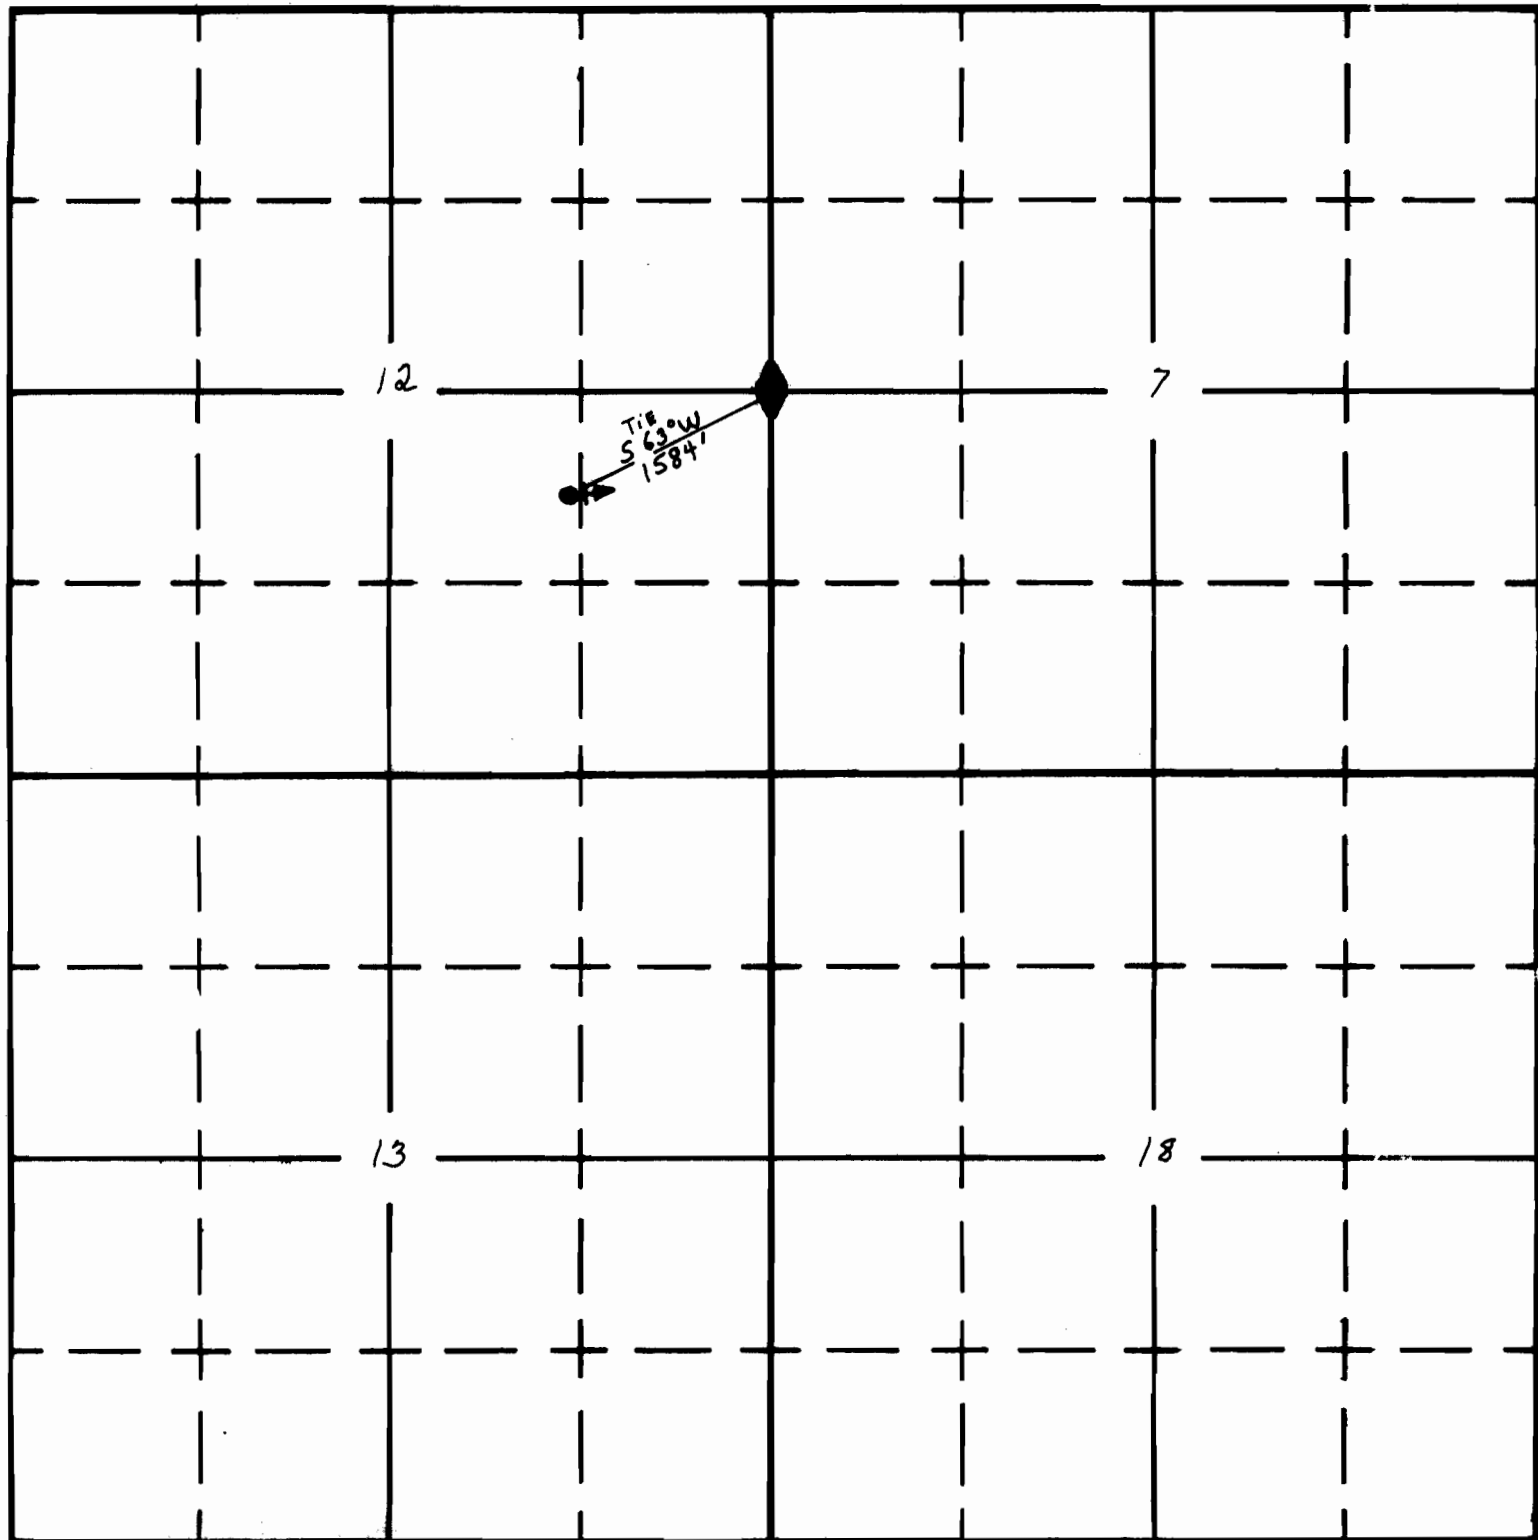

South

APPLICATION No. 3530  
PERMIT No. 28014