


# T.24&25S.R.36E.W.M.

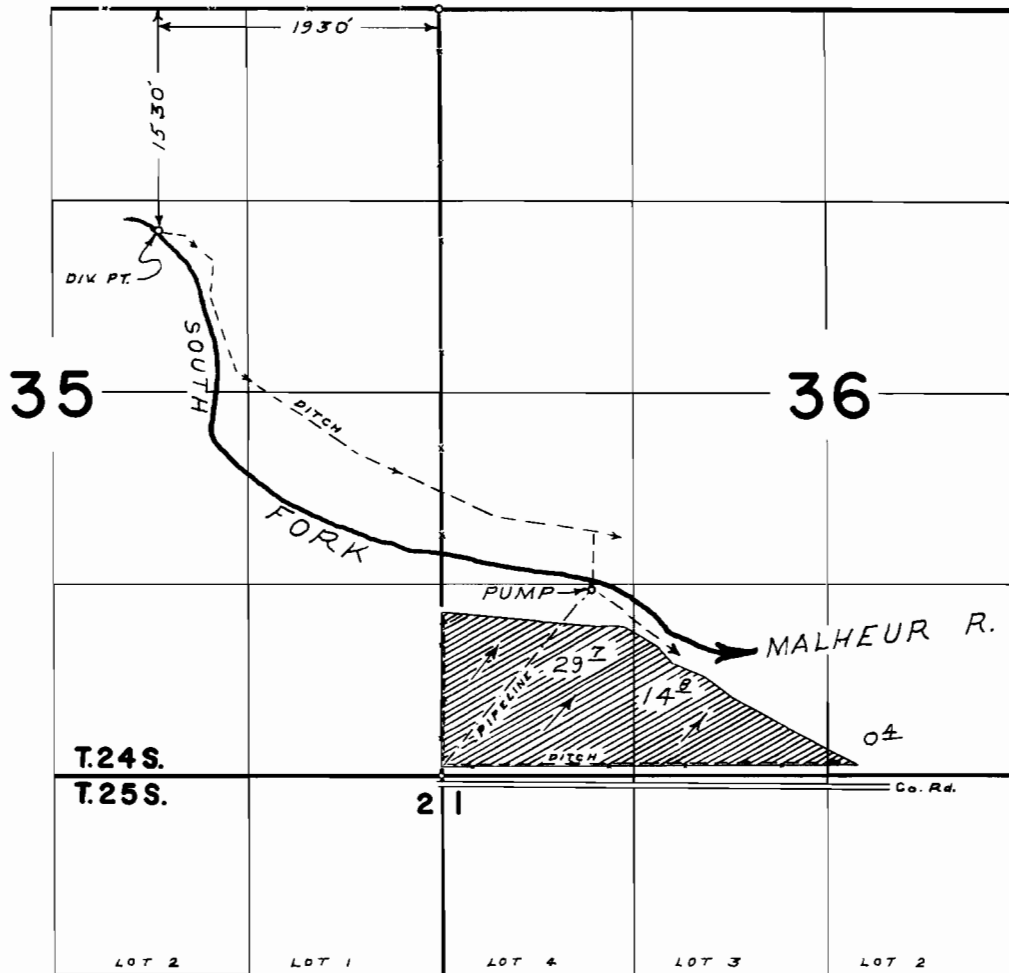

## FINAL PROOF SURVEY UNDER

Application No. **34884** Permit No. **27918**  
IN NAME OF

**LEE CABLES**

Surveyed **SEPT. 13** 1968, by **W. J. RUPPERT**