


P# 37820

# T.3N.,R.10E.,W.M.

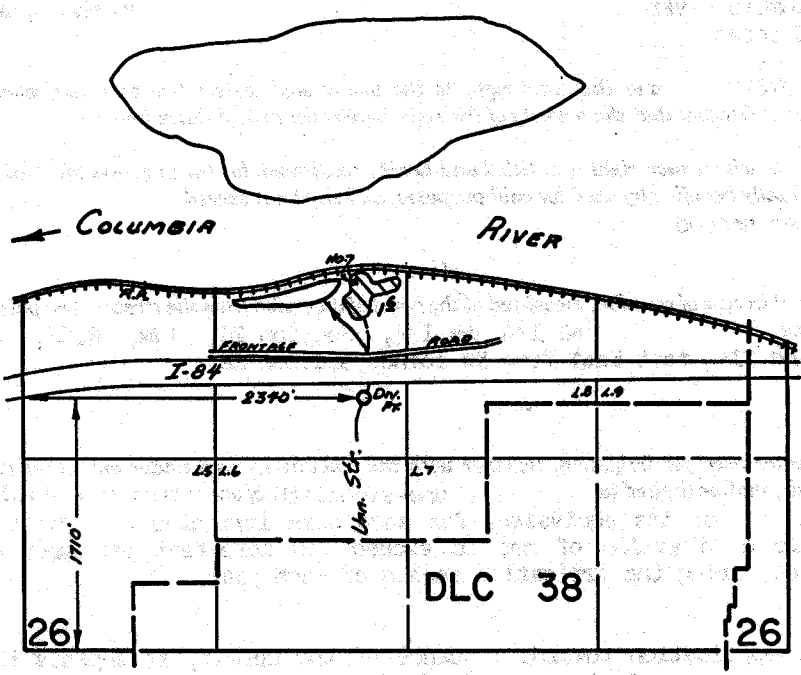

## FINAL PROOF SURVEY UNDER

Application No. 51949... Permit No. 37820.....  
 IN NAME OF  
**LUCILE A. &**  
**ESTATE OF TEUNIS J. WYERS.....**  
 Surveyed May...16.. 1980., by R.G.MUCKEN.....