


T. 3N., R. 10E., W.M.

P# 38940

SEC. 26

NE Cor.
NW 1/4 SW 1/4

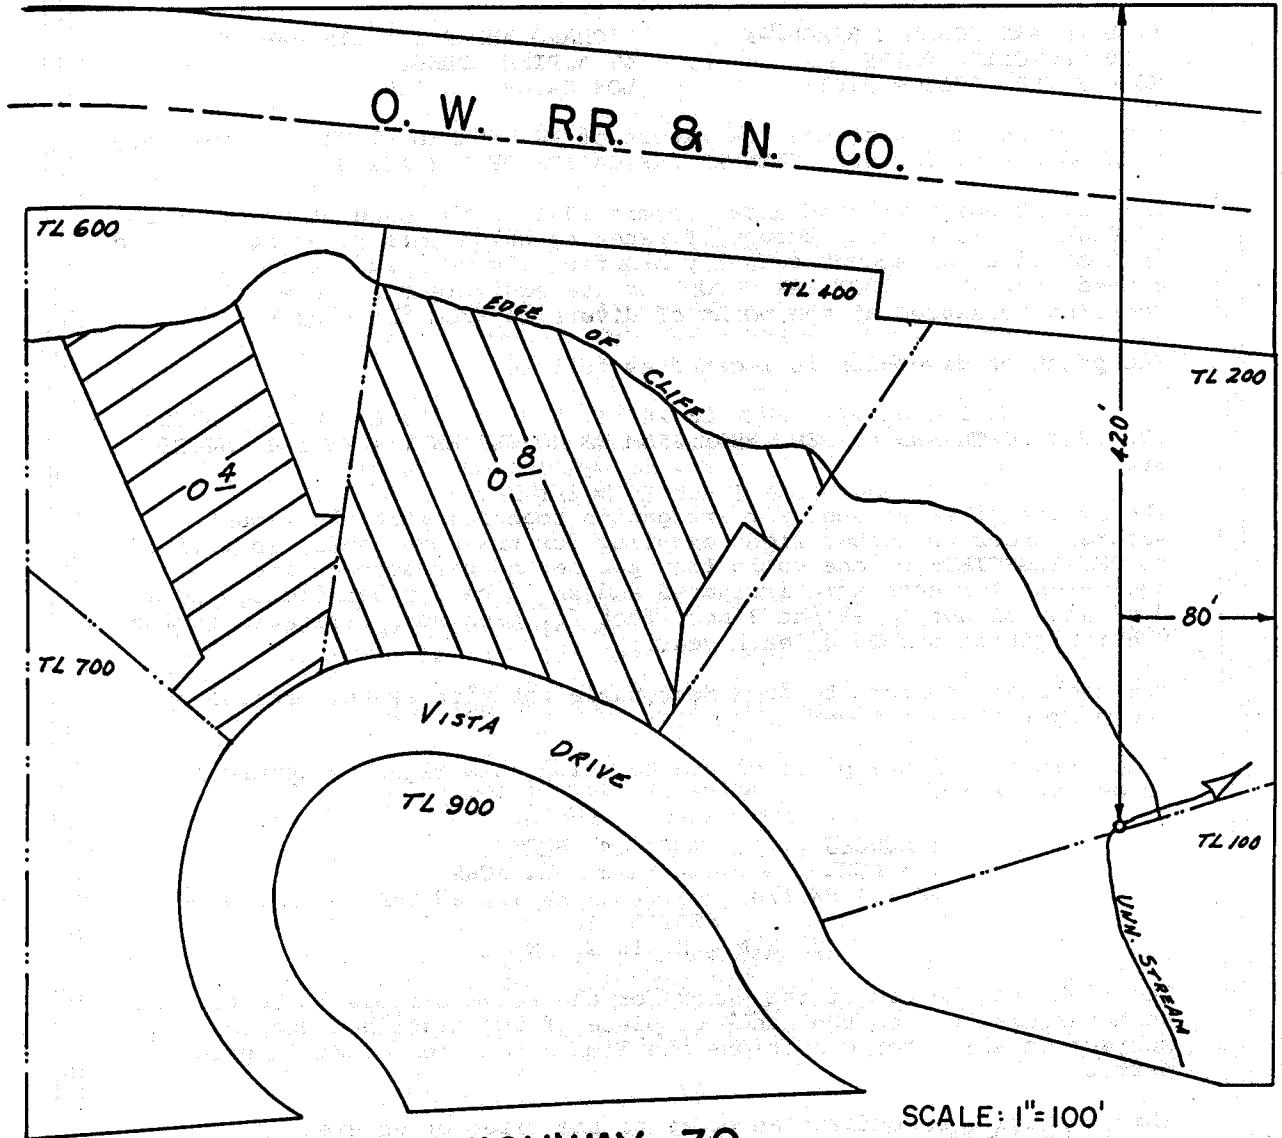

SCALE: 1"=100'

U.S. HIGHWAY 30
FINAL PROOF SURVEY
UNDER

 KRIVAK
 TONN

Application No. 51639... Permit No. 38940.....
IN NAME OF

ANTON B. KRIVAK & AUDREY M. TONN

Surveyed APR. 16... 1980, by R.G. MUCKEN.....

CHAIN SURVEY &
ASSESSOR PLAT 508