
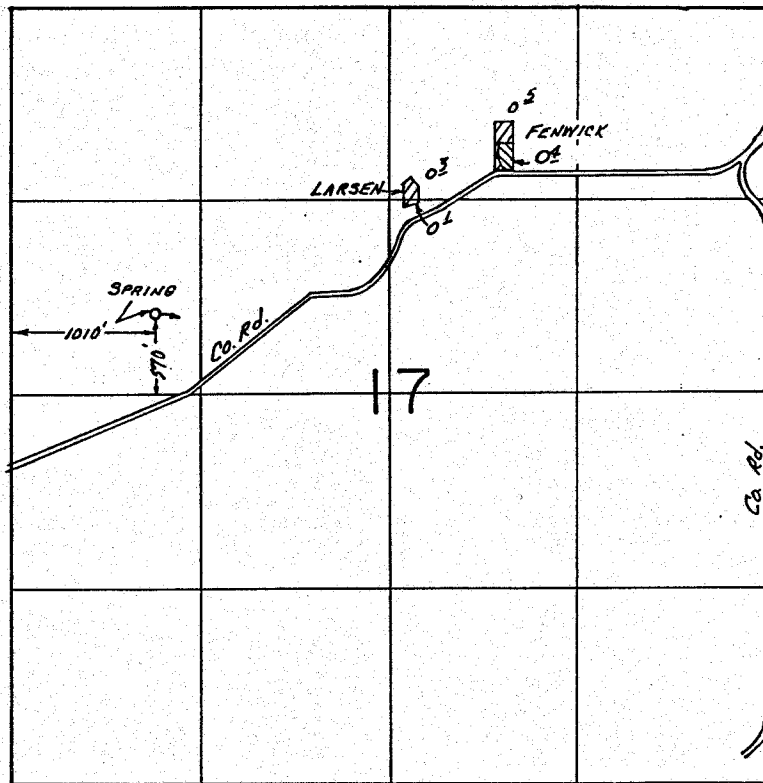
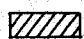


P# 43647

T. 2N., R. 10E., W.M.

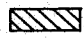

 Primary
 Suppl

FINAL PROOF SURVEY
UNDER

Application No. 57958... Permit No. 43647.....
IN NAME OF

MR. & MRS. DWIGHT J. LARSEN & MR. & MRS. FRANK FENWICK

Surveyed Sept. 24, 1981, by L.M. TOLL.....

27-87 NW 1/4

BWB