


#43872

# T. 1 N. R. 10 E. W. M.

Application No. 58181  
Permit No. 43872

**RECEIVED**  
DEC 13 1978  
WATER RESOURCES DEPT.  
SALEM, OREGON

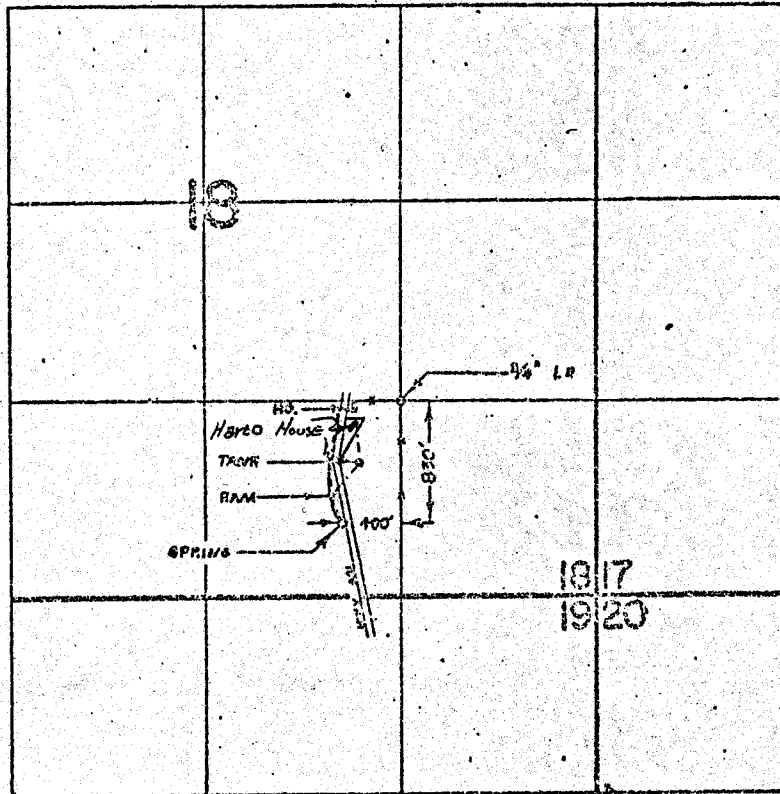

APPLICATION MAP FOR  
EARL B. HARTO

## FINAL PROOF SURVEY UNDER

Application No. 41066 Permit No. 30722  
 IN NAME OF  
 RICHARD C. FRAZIER  
 THIS MAP PREPARED BY:  
 FROM INFORMATION FURNISHED BY  
 THE APPLICANT.  
 Surveyed MAY 26, 1971, by J. MUCKEN